



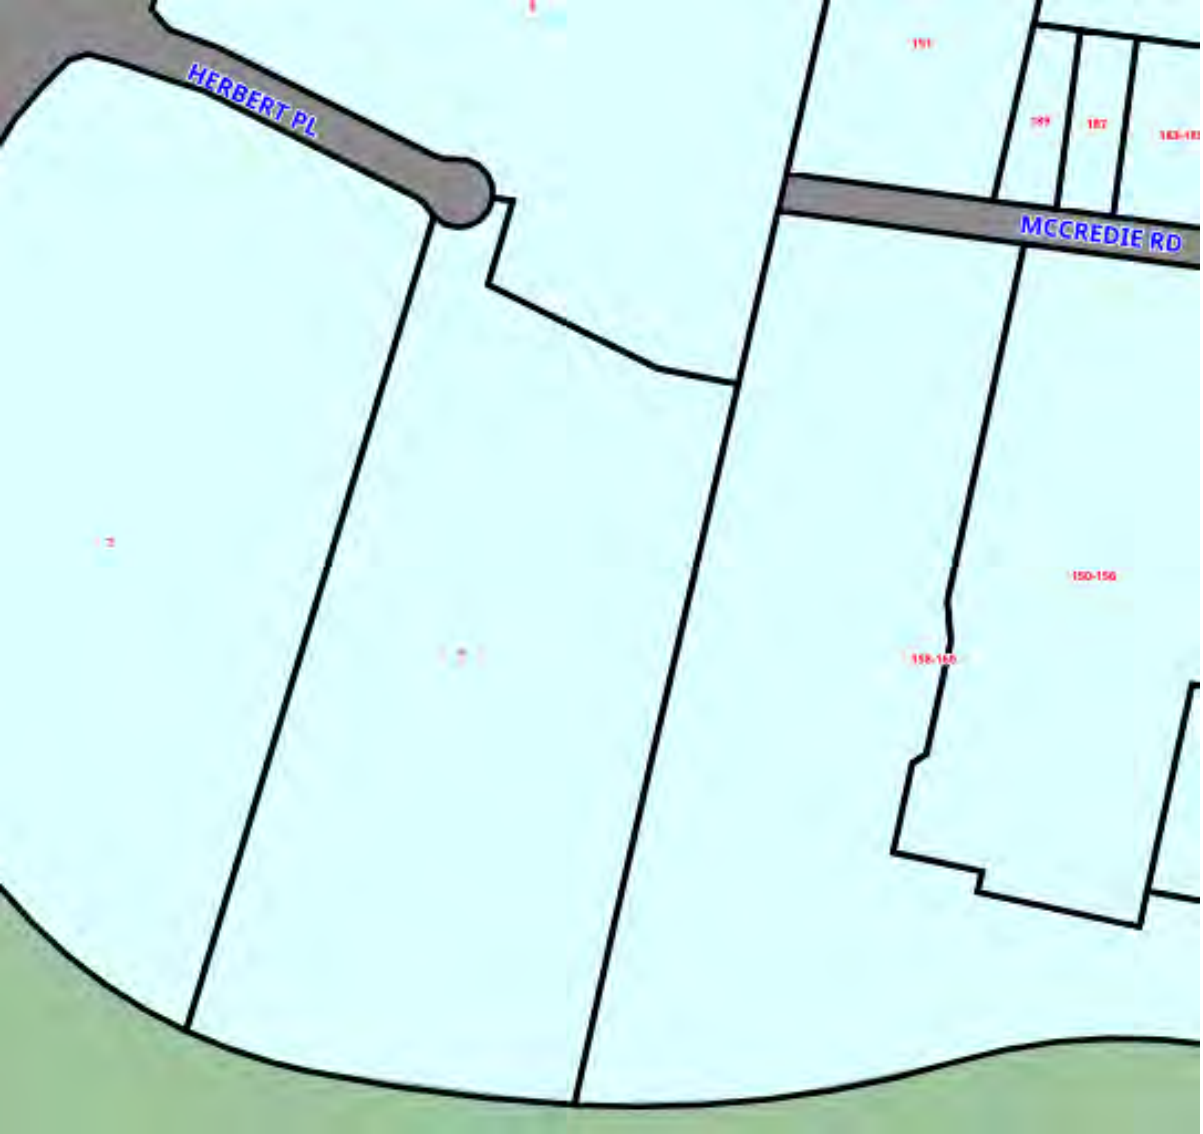

## APPENDIX C – Council flood mapping extracts

Source: Flood mapping dated 27/10/2021 sourced from Cumberland Council website accessed June 2023  
<https://www.cumberland.nsw.gov.au/stormwater-and-flood-maps>



# Map 1 - Flood Control Lot Map

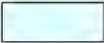





-  Properties within the Flood Planning Level area
-  Flood study required
-  Additional Properties totally or partially within the Floodplain

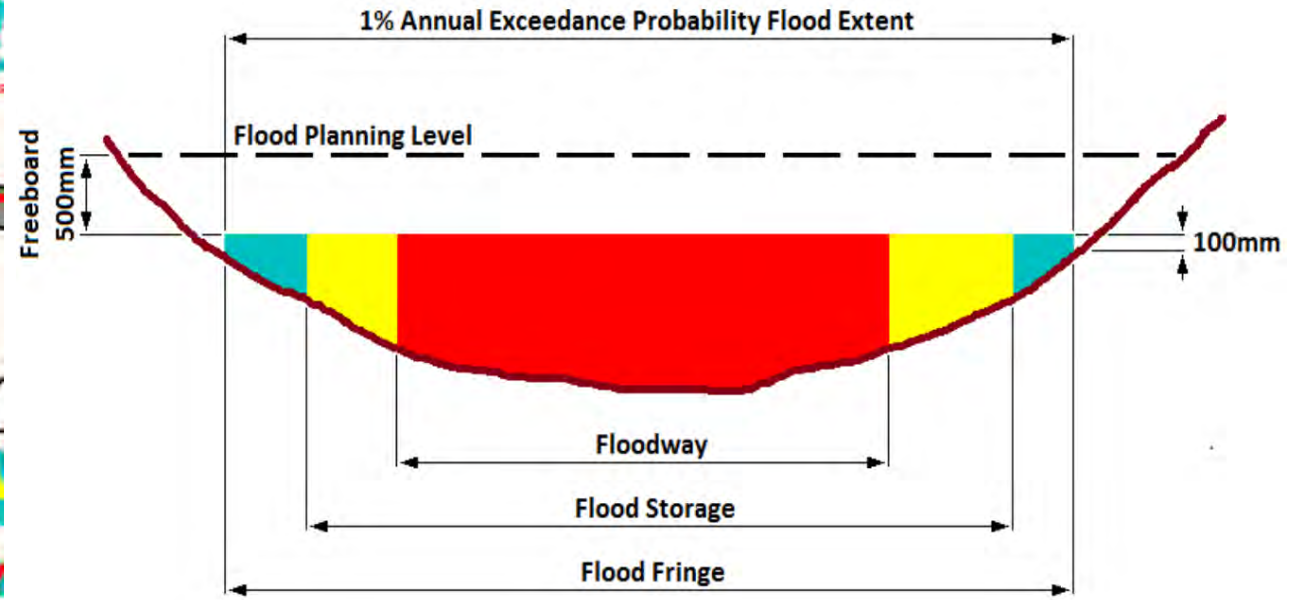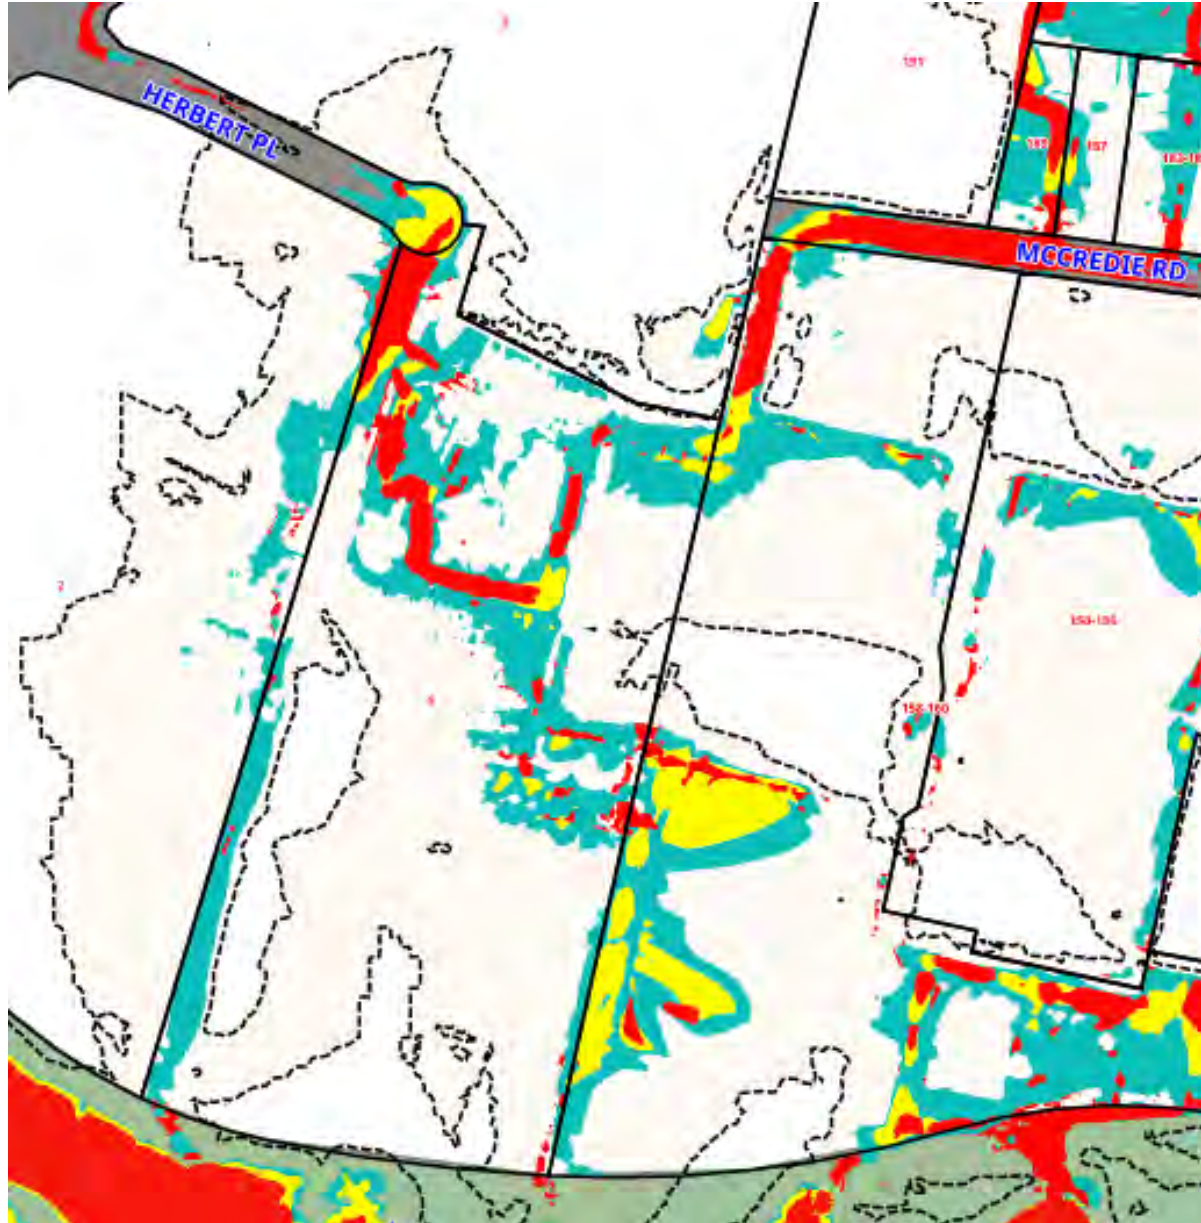


# Map 2 - 1% Flood Hydraulic Categories Map





-  FPL (Flood Planning Level Zone)
-  Floodway (1%)
-  Flood Storage (1%)
-  Flood Fringe (1%)

# Map 3 - Provisional Flood Hazard Categories Map

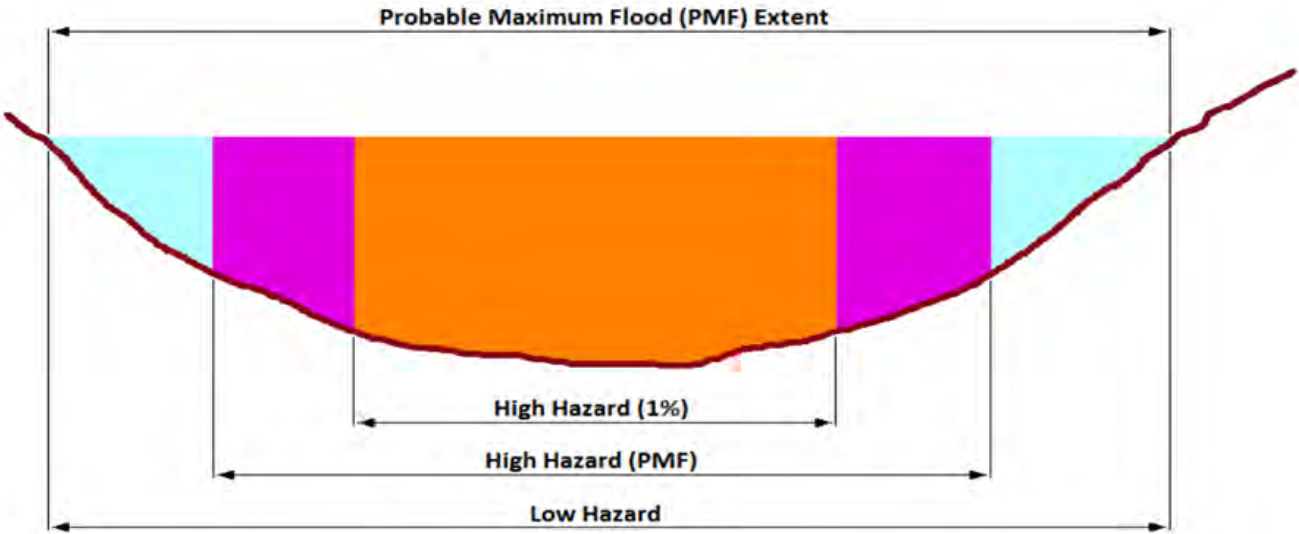



-  High Hazard (PMF)
-  High Hazard (1%)
-  Low Hazard (PMF)

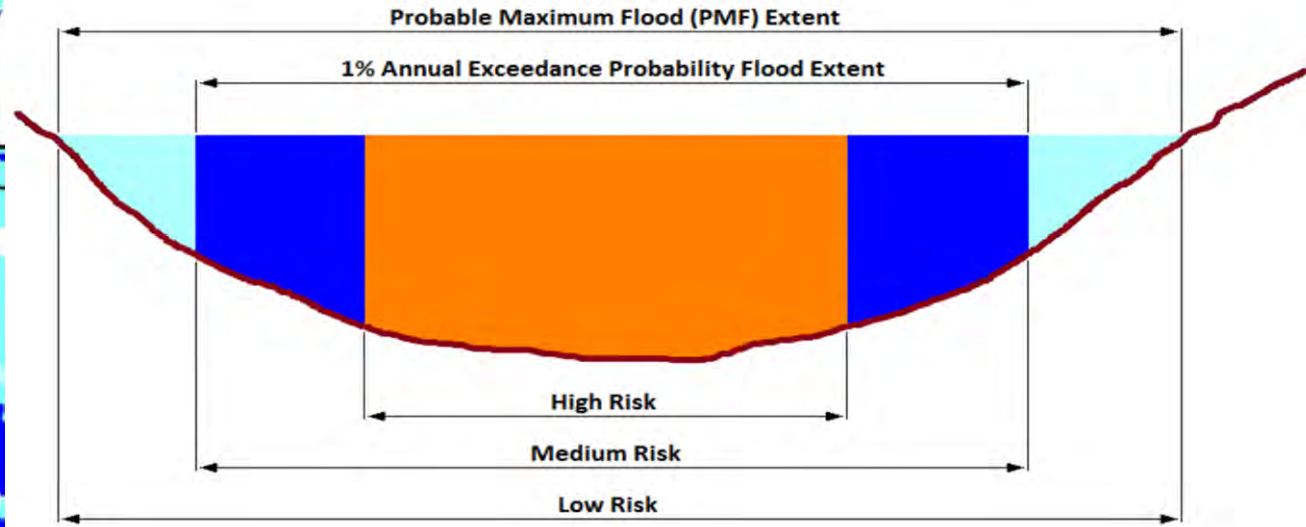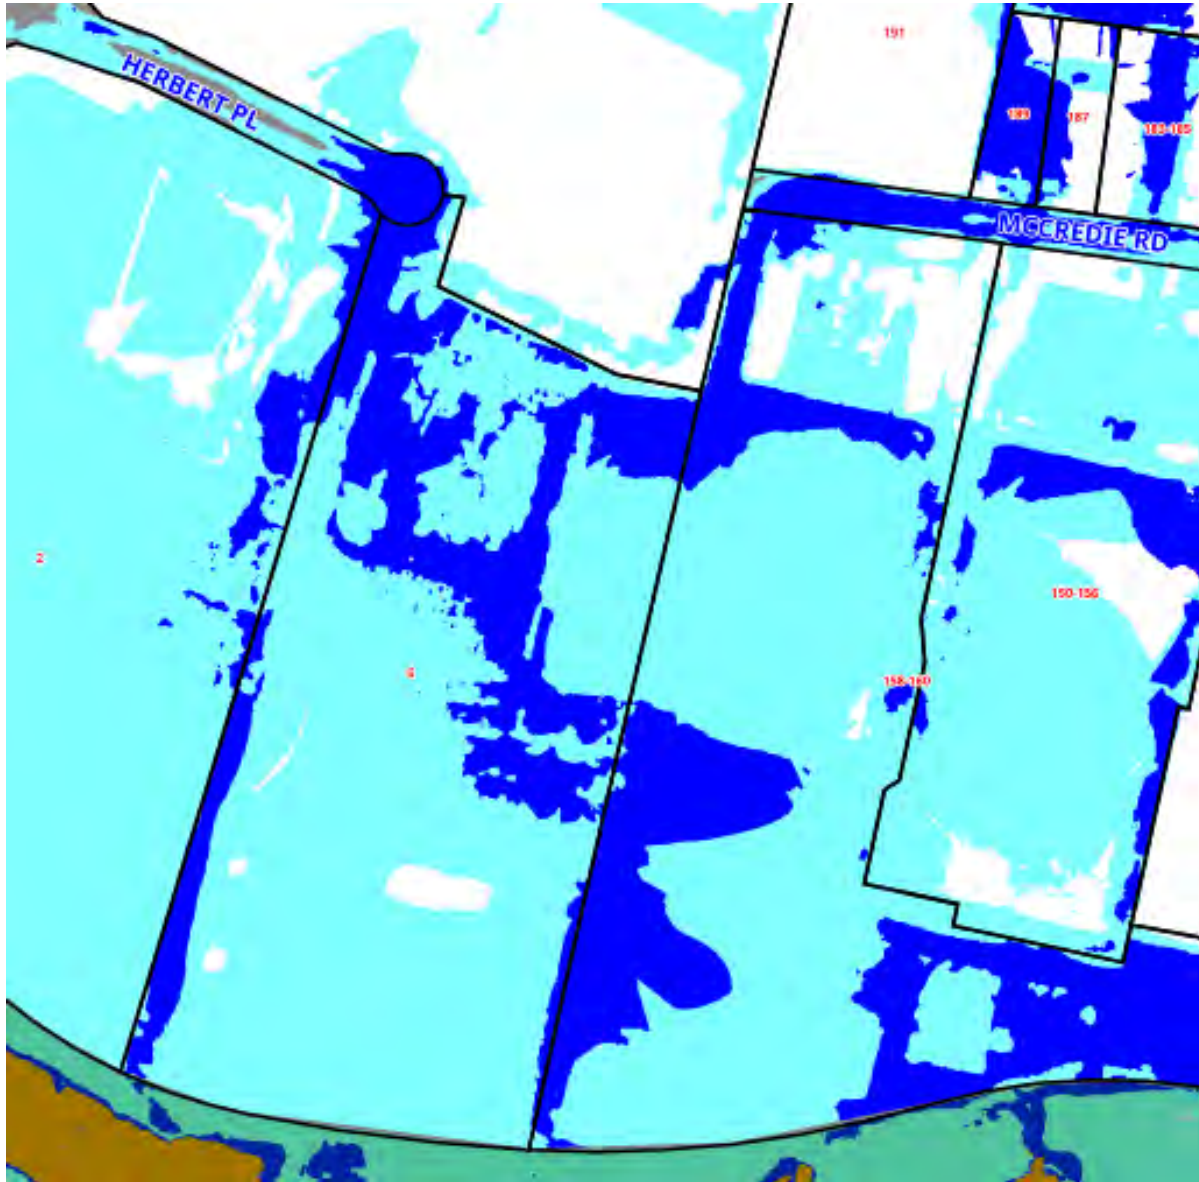

# Map 4 - Flood Risk Precincts Map




-  High Risk (1%)
-  Medium Risk (1%)
-  Low Risk (PMF)
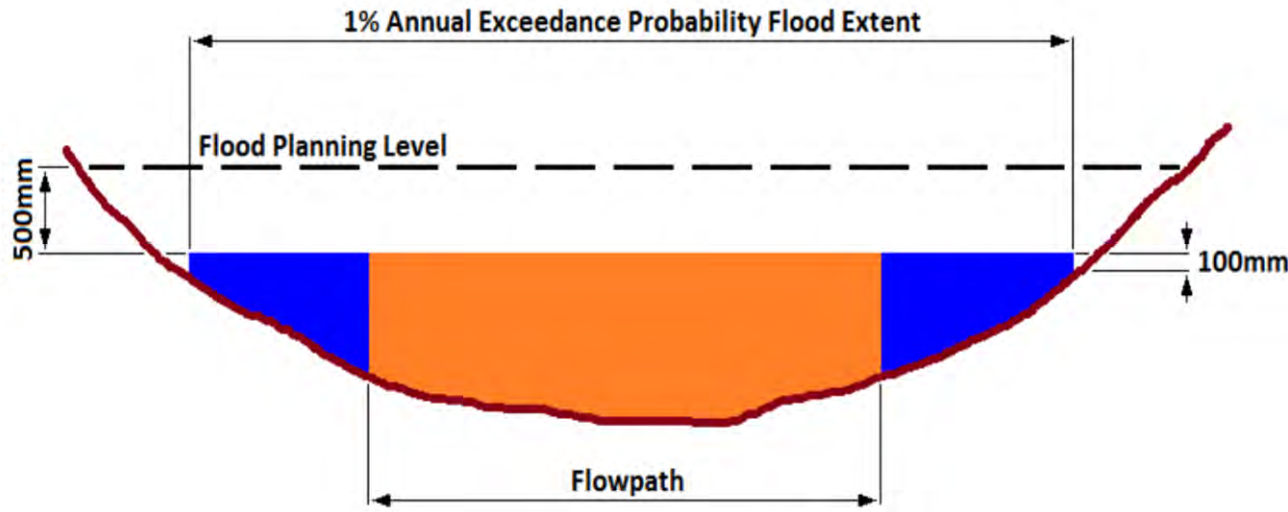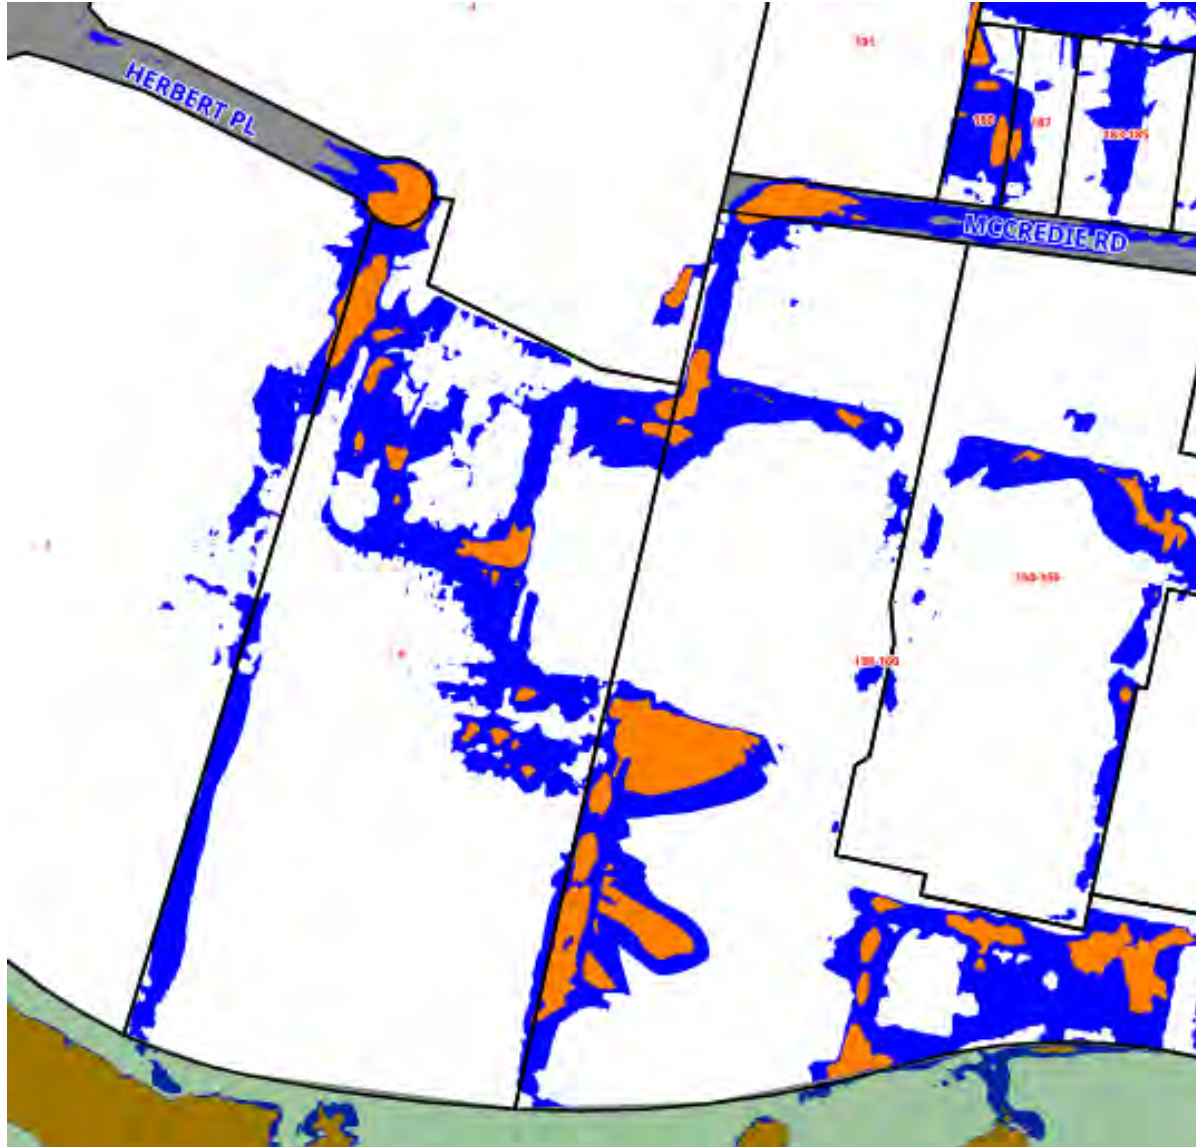
# Map 5 - Flowpaths



-  Extent of the 1% Flood
-  Flowpath (1%)


# Map 6 CDC Exclusive Zone

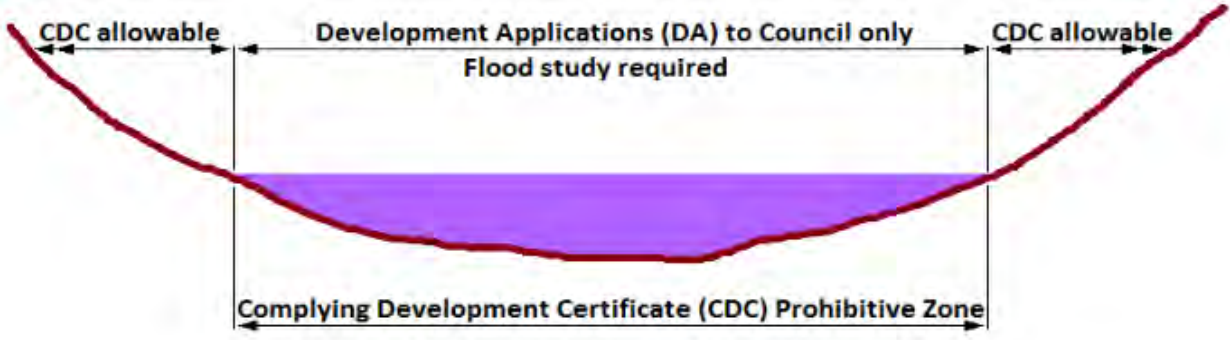





Under Section 3.5(1) of the SEPP (Exempt and Complying Development) a CD must not be issued for development partially or totally within this area.

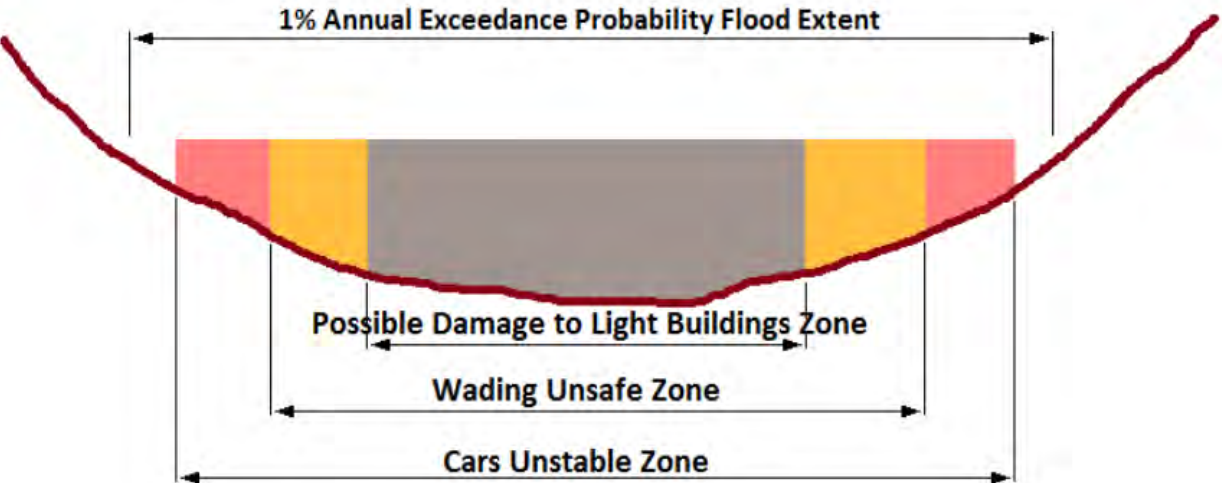-  **CDC prohibitive zones**
-  **Park**



# Map 7 - Unsafe 1% flood areas







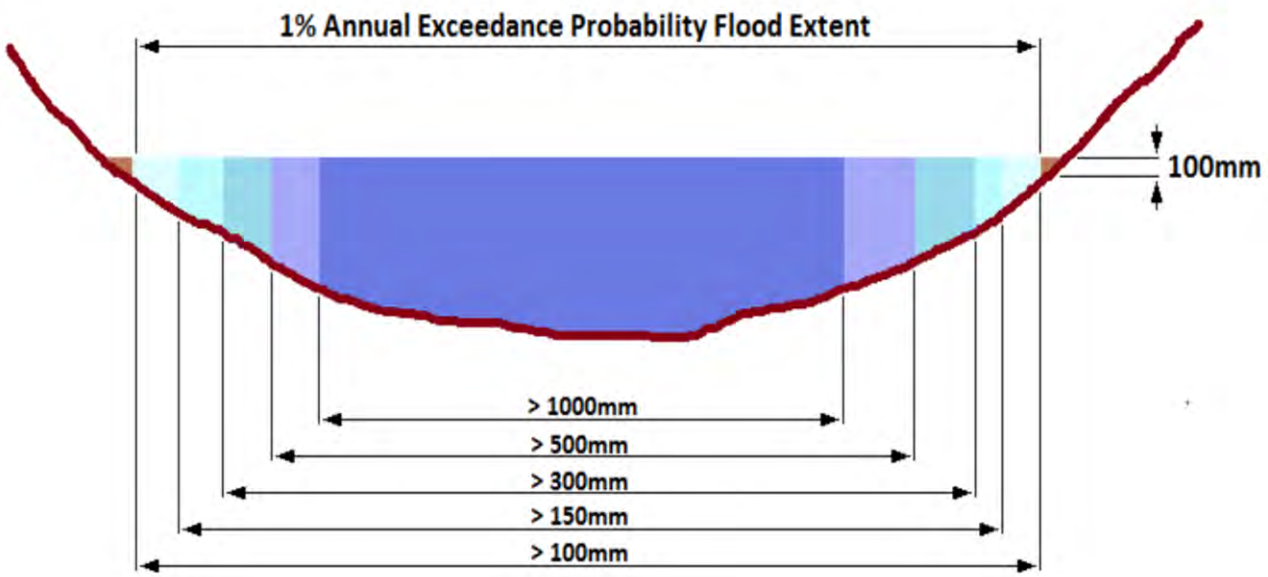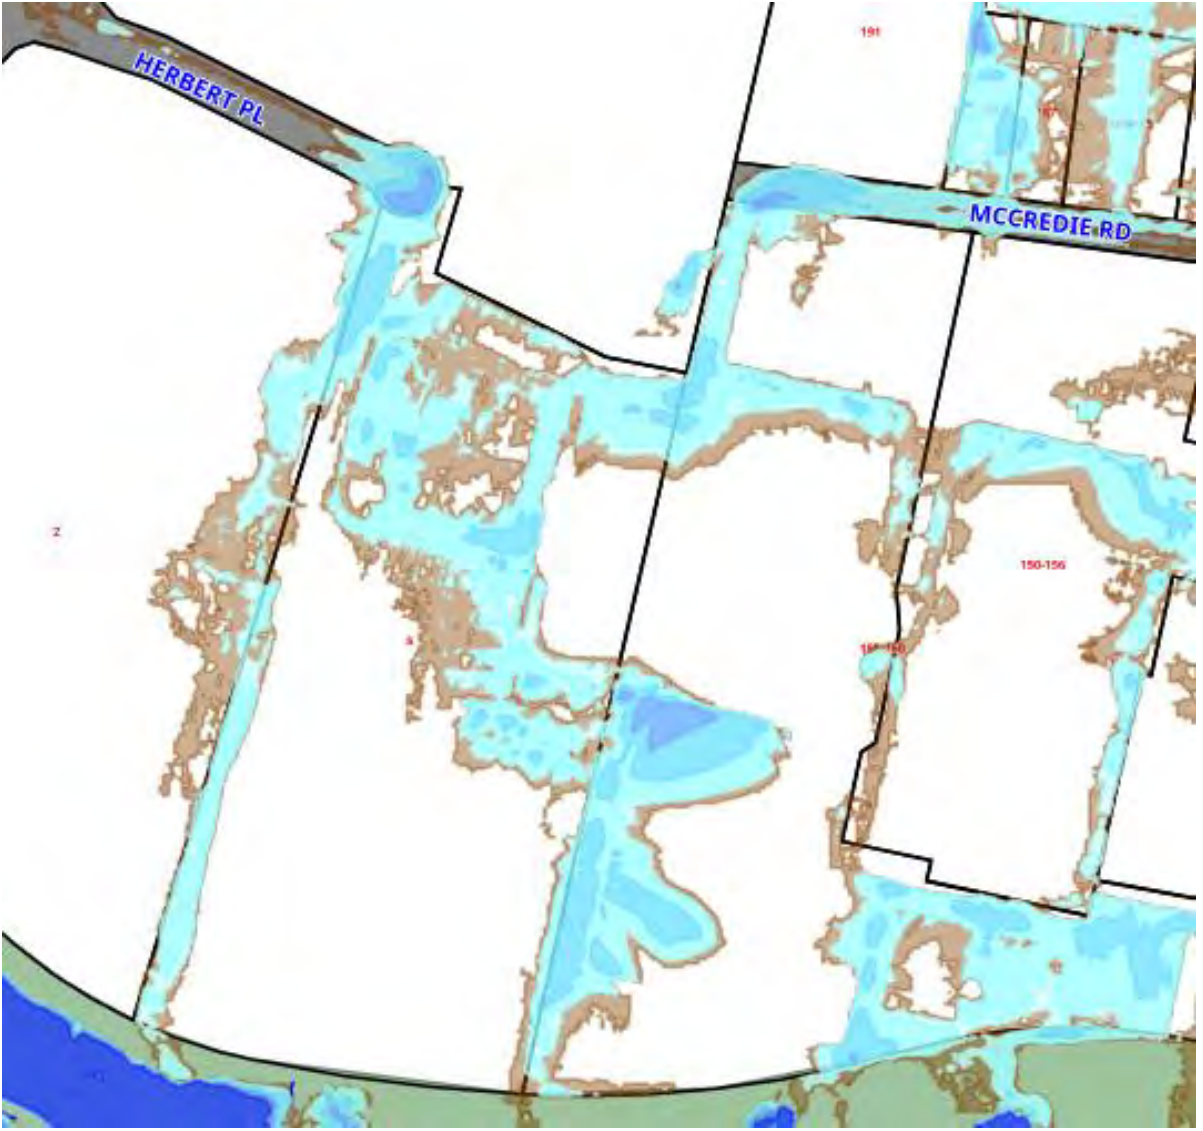

-  **Cars Unstable Zone**
-  **Wading Unsafe Zone**
-  **Damage to Light Buildings Zone**
-  **Park**






# Map 8 Catchments and 1% AEP Depths



-  < 0.1m deep
-  0.1m to 0.15m deep
-  0.15m to 0.3m deep
-  0.3m to 0.5m deep
-  0.5m to 1.0m deep
-  Greater than 1.0m deep

## **APPENDIX D – Existing site drainage drawings**

- Runoff from roof and gravel areas
- Runoff from road surfaces
- Runoff from steam turbine area, washdown areas and bunded areas
- Discharge to sewer

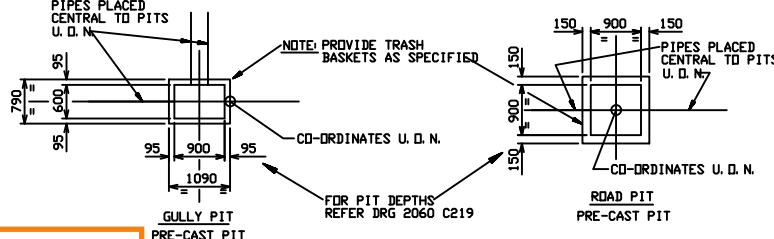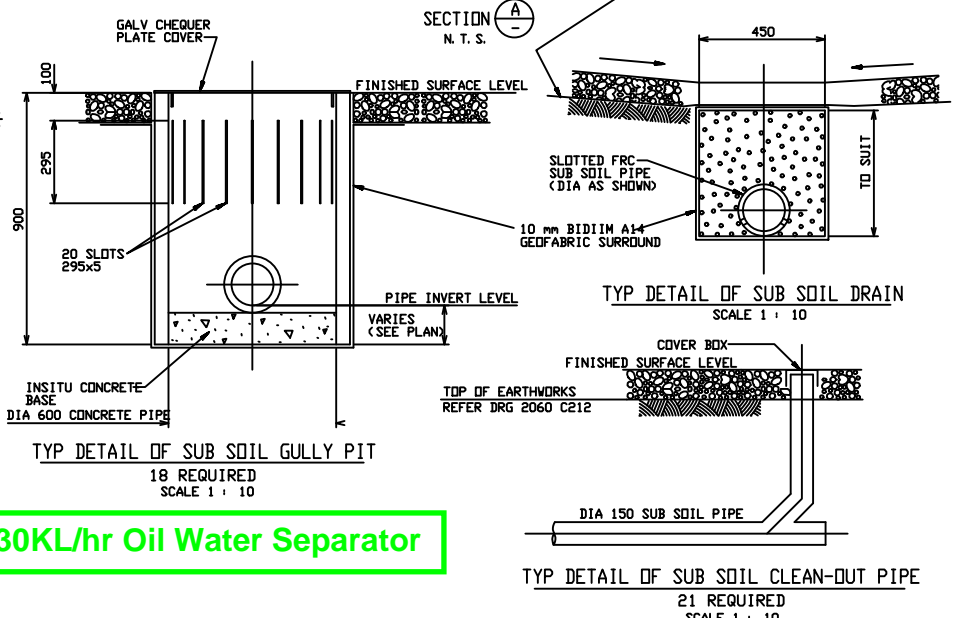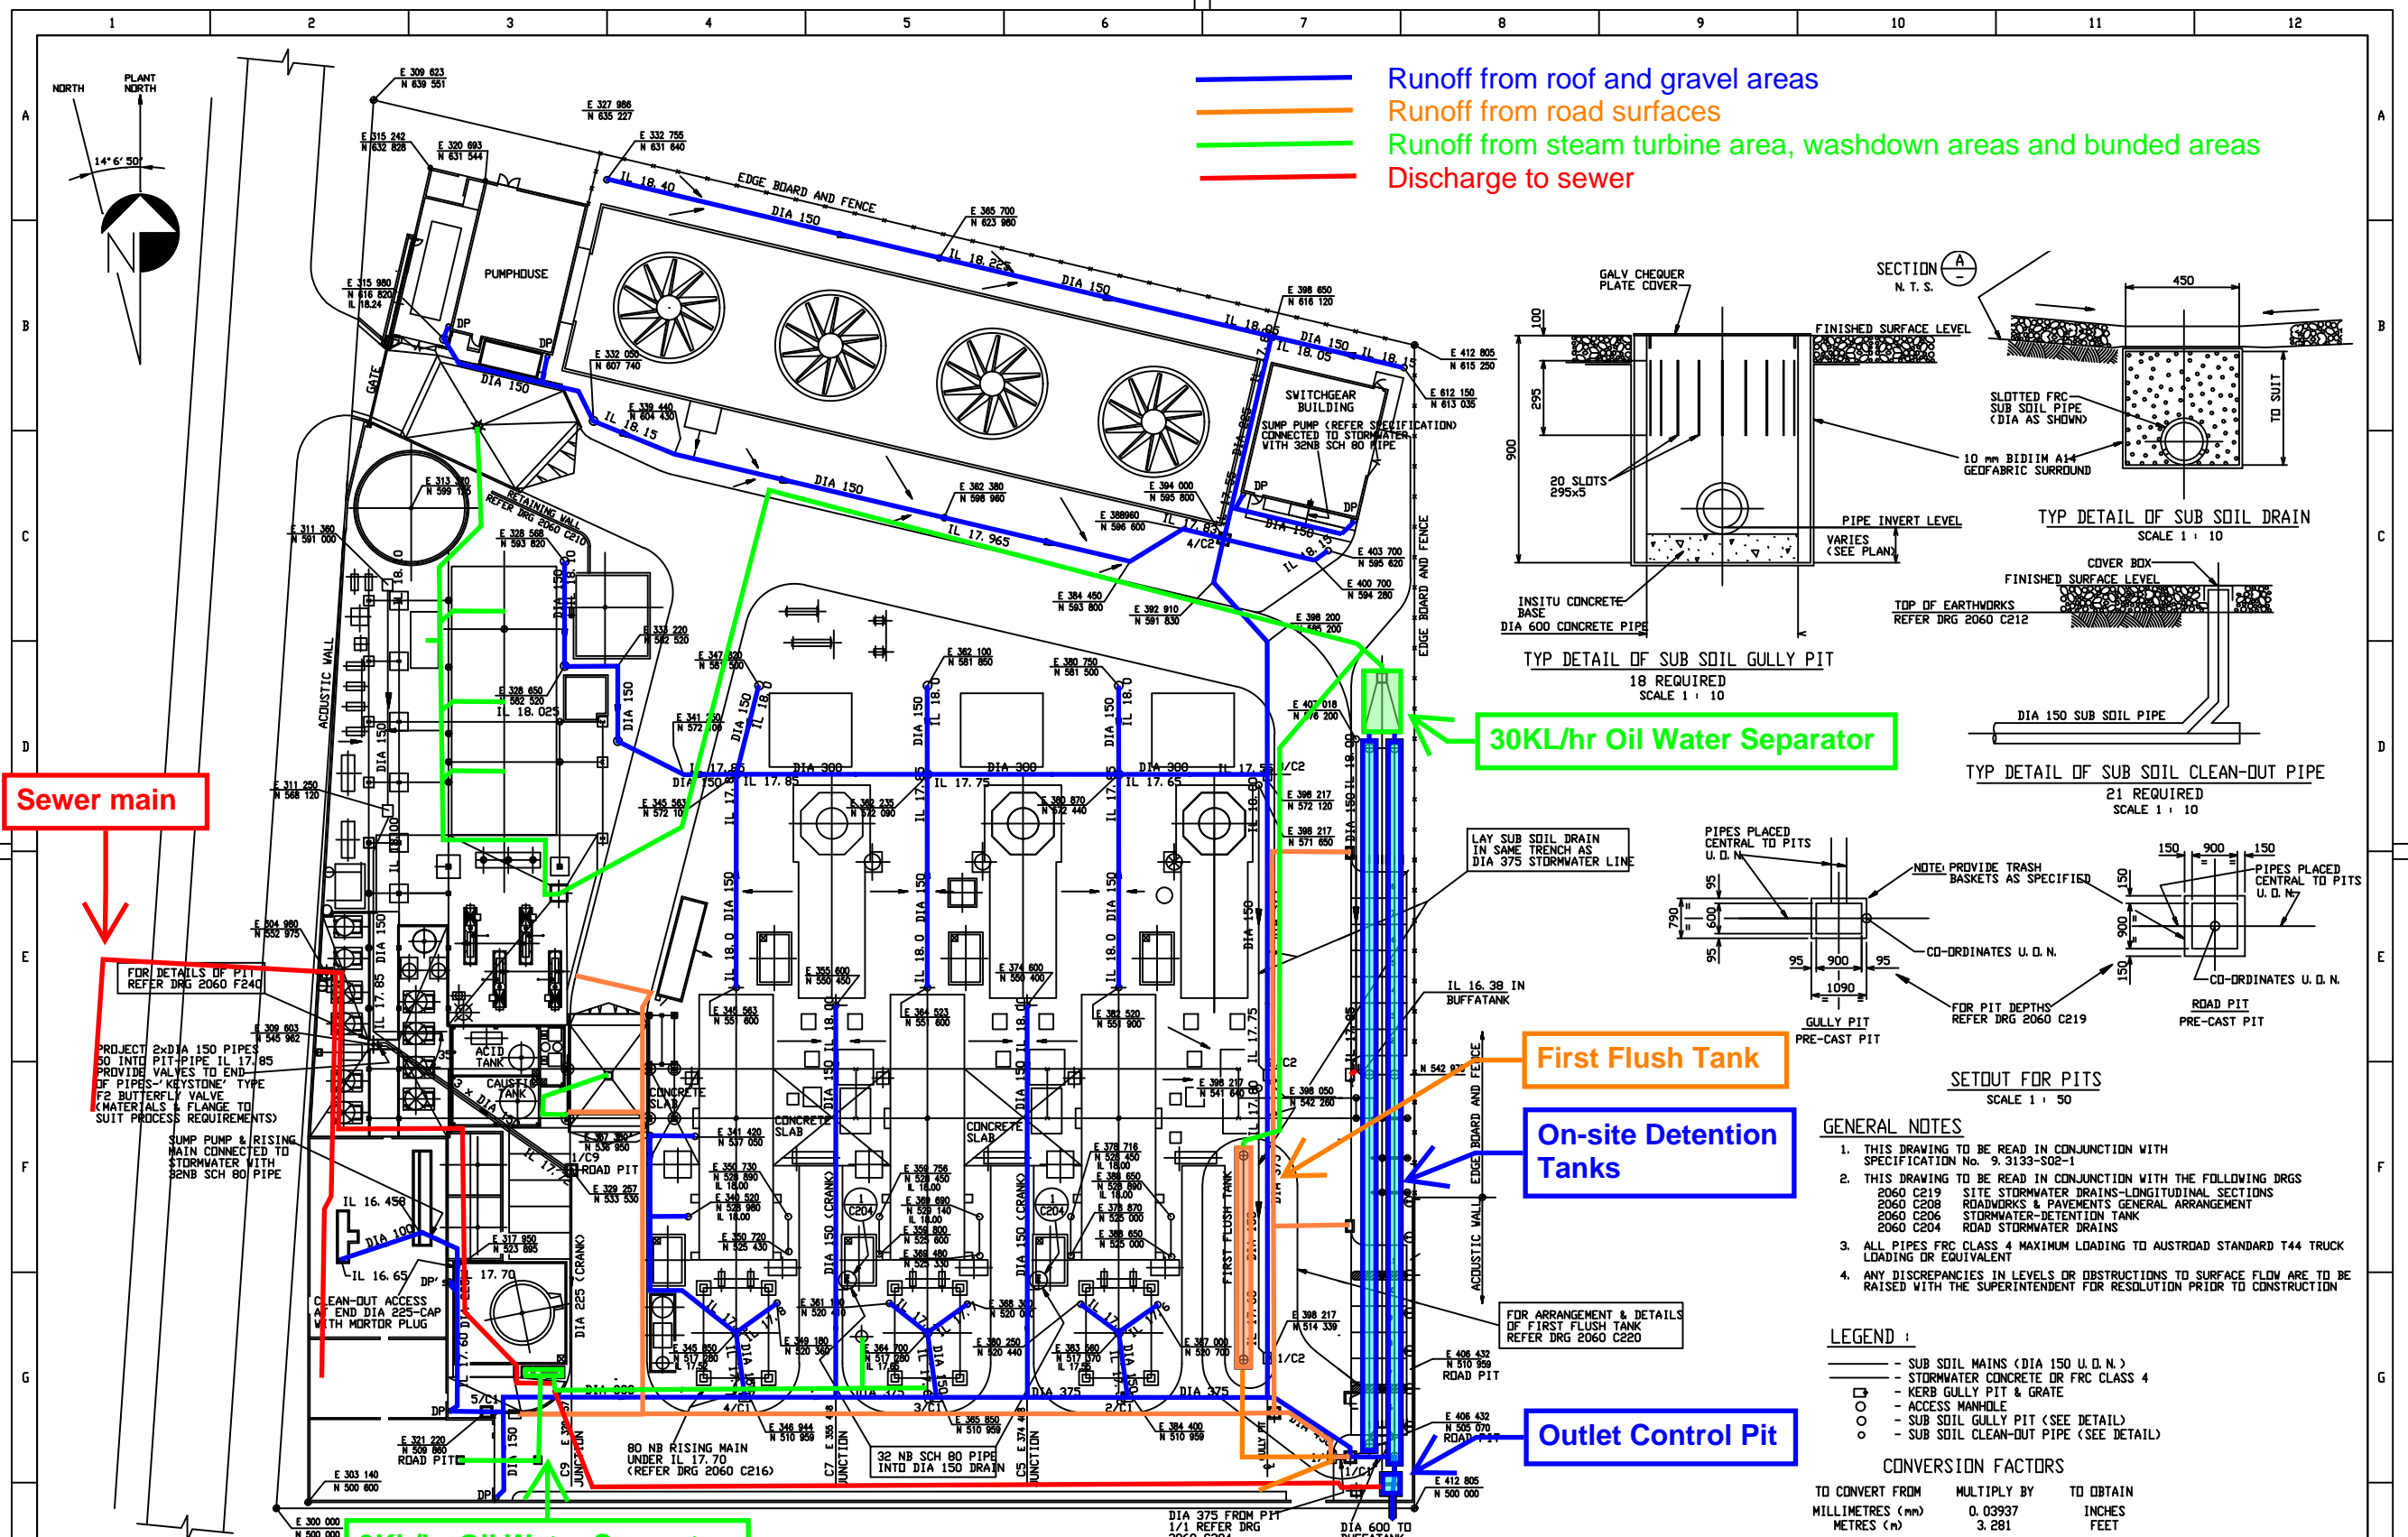

- GENERAL NOTES**
- THIS DRAWING TO BE READ IN CONJUNCTION WITH SPECIFICATION No. 9.3133-S02-1
  - THIS DRAWING TO BE READ IN CONJUNCTION WITH THE FOLLOWING DRGS  
 2060 C219 SITE STORMWATER DRAINS-LONGITUDINAL SECTIONS  
 2060 C208 ROADWORKS & PAVEMENTS GENERAL ARRANGEMENT  
 2060 C206 STORMWATER-DETENTION TANK  
 2060 C204 ROAD STORMWATER DRAINS
  - ALL PIPES FRC CLASS 4 MAXIMUM LOADING TO AUSTRAD STANDARD T44 TRUCK LOADING OR EQUIVALENT
  - ANY DISCREPANCIES IN LEVELS OR OBSTRUCTIONS TO SURFACE FLOW ARE TO BE RAISED WITH THE SUPERINTENDENT FOR RESOLUTION PRIOR TO CONSTRUCTION

- LEGEND :**
- SUB SOIL MAINS (DIA 150 U.D.N.)
  - STORMWATER CONCRETE DR FRC CLASS 4
  - KERB GULLY PIT & GRATE
  - ACCESS MANHOLE
  - SUB SOIL GULLY PIT (SEE DETAIL)
  - SUB SOIL CLEAN-OUT PIPE (SEE DETAIL)

**CONVERSION FACTORS**

TO CONVERT FROM	MULTIPLY BY	TO OBTAIN
MILLIMETRES (mm)	0.03937	INCHES
METRES (m)	3.281	FEET

**Sewer main**

**30KL/hr Oil Water Separator**

**First Flush Tank**

**On-site Detention Tanks**


**Outlet Control Pit**

**3KL/hr Oil Water Separator**

REV.	DATE	DRN	CHKD	DESIGNED	VERIFIED	DESCRIPTION
D	21-1-97	B.F.S.	BFS/HA			
C	31-5-96	B.F.S.	J. DICKSON	J. DICKSON	R. BINNS	T. STEELE
B	1-4-96	B.F.S.	J. DICKSON	J. DICKSON	R. BINNS	R. STEELE
A	23-2-96	D. TIERNEY	J. DICKSON	J. DICKSON	R. BINNS	R. STEELE
3	16-2-96	D. TIERNEY	J. DICKSON	J. DICKSON	R. BINNS	R. STEELE
D	5-10-95	D. TIERNEY	J. DICKSON	J. DICKSON	H. AGUERO	ISSUED FOR APPROVAL

**NOTES**

- DIMENSIONS IN MILLIMETRES
- DRAWING PRACTICE TO AS 1100

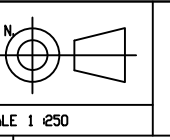


TRANSFIELD NEPCO Transfield Joint Venture

THIS DRAWING AND DESIGN IS THE PROPERTY OF TRANSFIELD CONSTRUCTION PTY. LTD. IT MUST NOT BE COPIED OR REPRODUCED IN ANY WAY WHATSOEVER AND/OR PASSED ON TO ANY THIRD PARTY WITHOUT WRITTEN AUTHORITY FROM TRANSFIELD CONSTRUCTION PTY. LTD. 100 ARTHUR STREET, NORTH SYDNEY 2060, N.S.W. AUSTRALIA TEL: (02) 959 8600, FAX: (02) 954 0538

SMITHFIELD ENERGY FACILITY  
 SMITHFIELD, N.S.W. AUSTRALIA  
 SITE STORMWATER DRAINS  
 GENERAL ARRANGEMENT

DRG NO.	2060 C213
SHEET	1/1
REV	A B C D

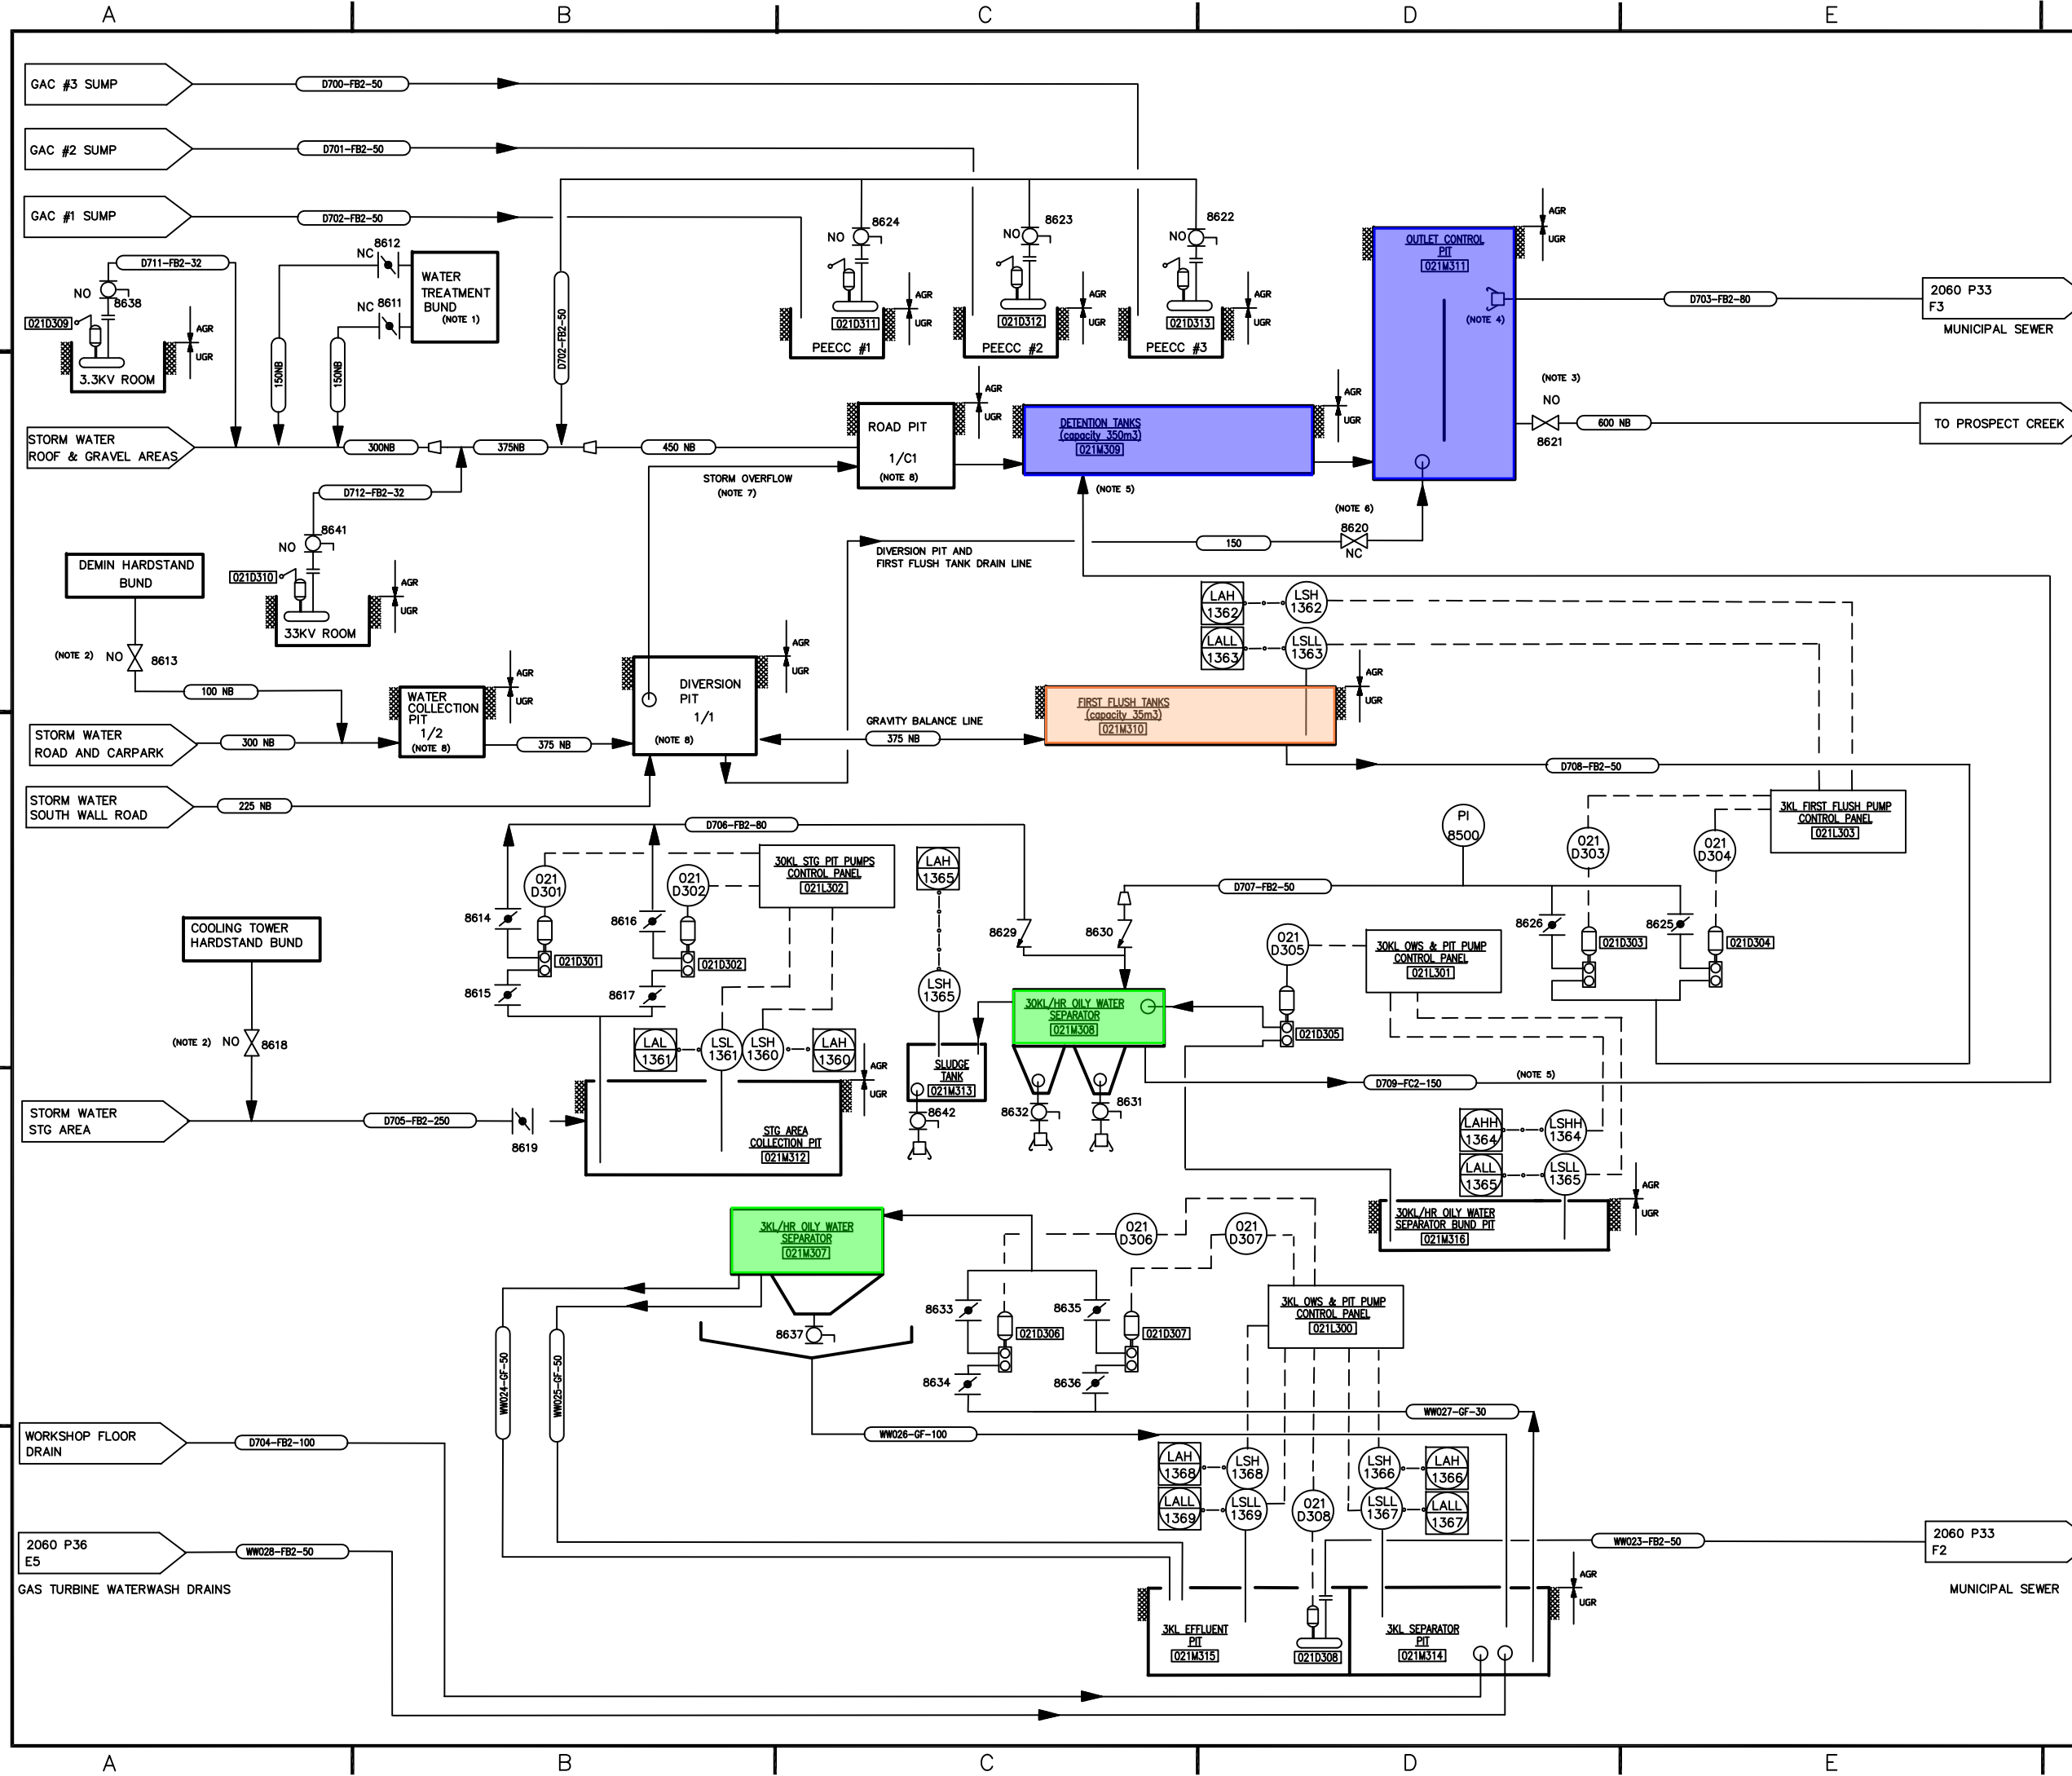

**GENERAL NOTES:**

1. VALVES TO BE OPENED TO DRAIN STORM WATER. AFTER SAMPLING TO ENSURE pH AND CONTAMINATION ARE AS PER PROTOCOL (SEE PROTOCOL 15)
2. VALVES TO BE LEFT OPEN TO DRAIN STORM WATER. VALVES MUST BE CLOSED DURING CHEMICAL DELIVERY ARE AS PER PROTOCOL (SEE PROTOCOL 9 AND 15)
3. VALVE TO BE LEFT OPEN TO DRAIN STORM WATER. VALVE MUST BE CLOSED IN EMERGENCY SITUATIONS AS DETAILED IN SEF EMERGENCY PLAN SPCC AND PROTOCOL 15
4. CAMLOK FITTING TO ENABLE CONTROL PIT TO BE PUMPED OUT WITH PORTABLE SUBMERSIBLE PUMP TO SEWER (SEE SEF TRADE WASTE AGREEMENT)
5. GRAVITY DRAIN TO DETENTION TANKS
6. VALVE LOCKED IN SHUT POSITION. OPEN ONLY TO DRAIN DIVERSION PIT AND FIRST FLUSH TANK
7. STORM OVERFLOW BYPASSES OWS DURING HEAVY STORM CONDITIONS
8. THIS P&ID RELATES TO DRAWINGS 2060 C220, 2060 C216, 2060 C213 AND 2060 C204

**PIPE SIZES CONVERSION TABLE**




NOMINAL PIPE SIZE	
DN (mm) (SI METRIC)	NPS (IN.) (ANSI)
8	1/4
10	3/8
15	1/2
20	3/4
25	1
32	1 1/4
40	1 1/2
50	2
65	2 1/2
80	3
90	3 1/2
100	4
150	6
200	8
250	10
300	12
350	14
400	16
450	18
500	20
600	24
750	30
900	36
1200	48

REVISION	DATE	BY	CHECKED	PROJ. ENG.	APPROVED	MGR. ENG.
08 NOV 04						



DRAWN BY: S PILKINGTON      ENGINEERED BY:  
 SCALE: NONE  
 THIS DRAWING IS THE PROPERTY OF SITHE ENERGIES AUSTRALIA AND IS NOT TO BE USED IN ANY WAY INJURIOUS TO THEIR INTERESTS AND IS TO BE RETURNED UPON REQUEST.  
**SMITHFIELD ENERGY FACILITY**  
 SMITHFIELD, N.S.W. AUSTRALIA  
 STORM WATER SYSTEM P&ID  
 DWG. NO. 2060 P54

Runoff from roof and gravel areas

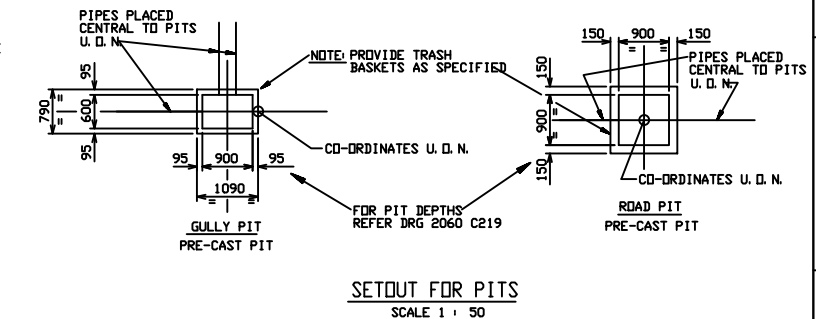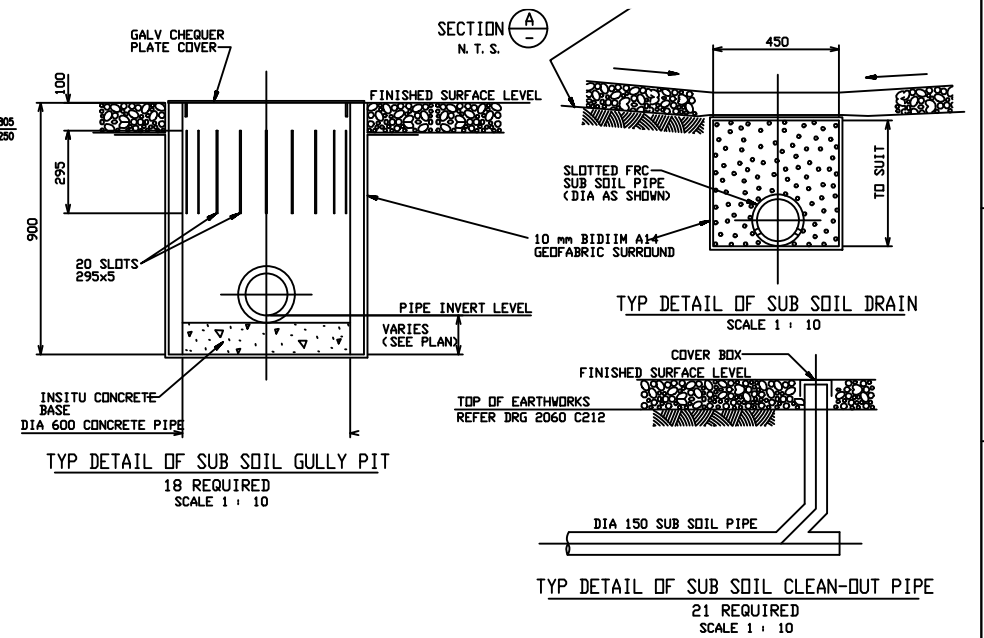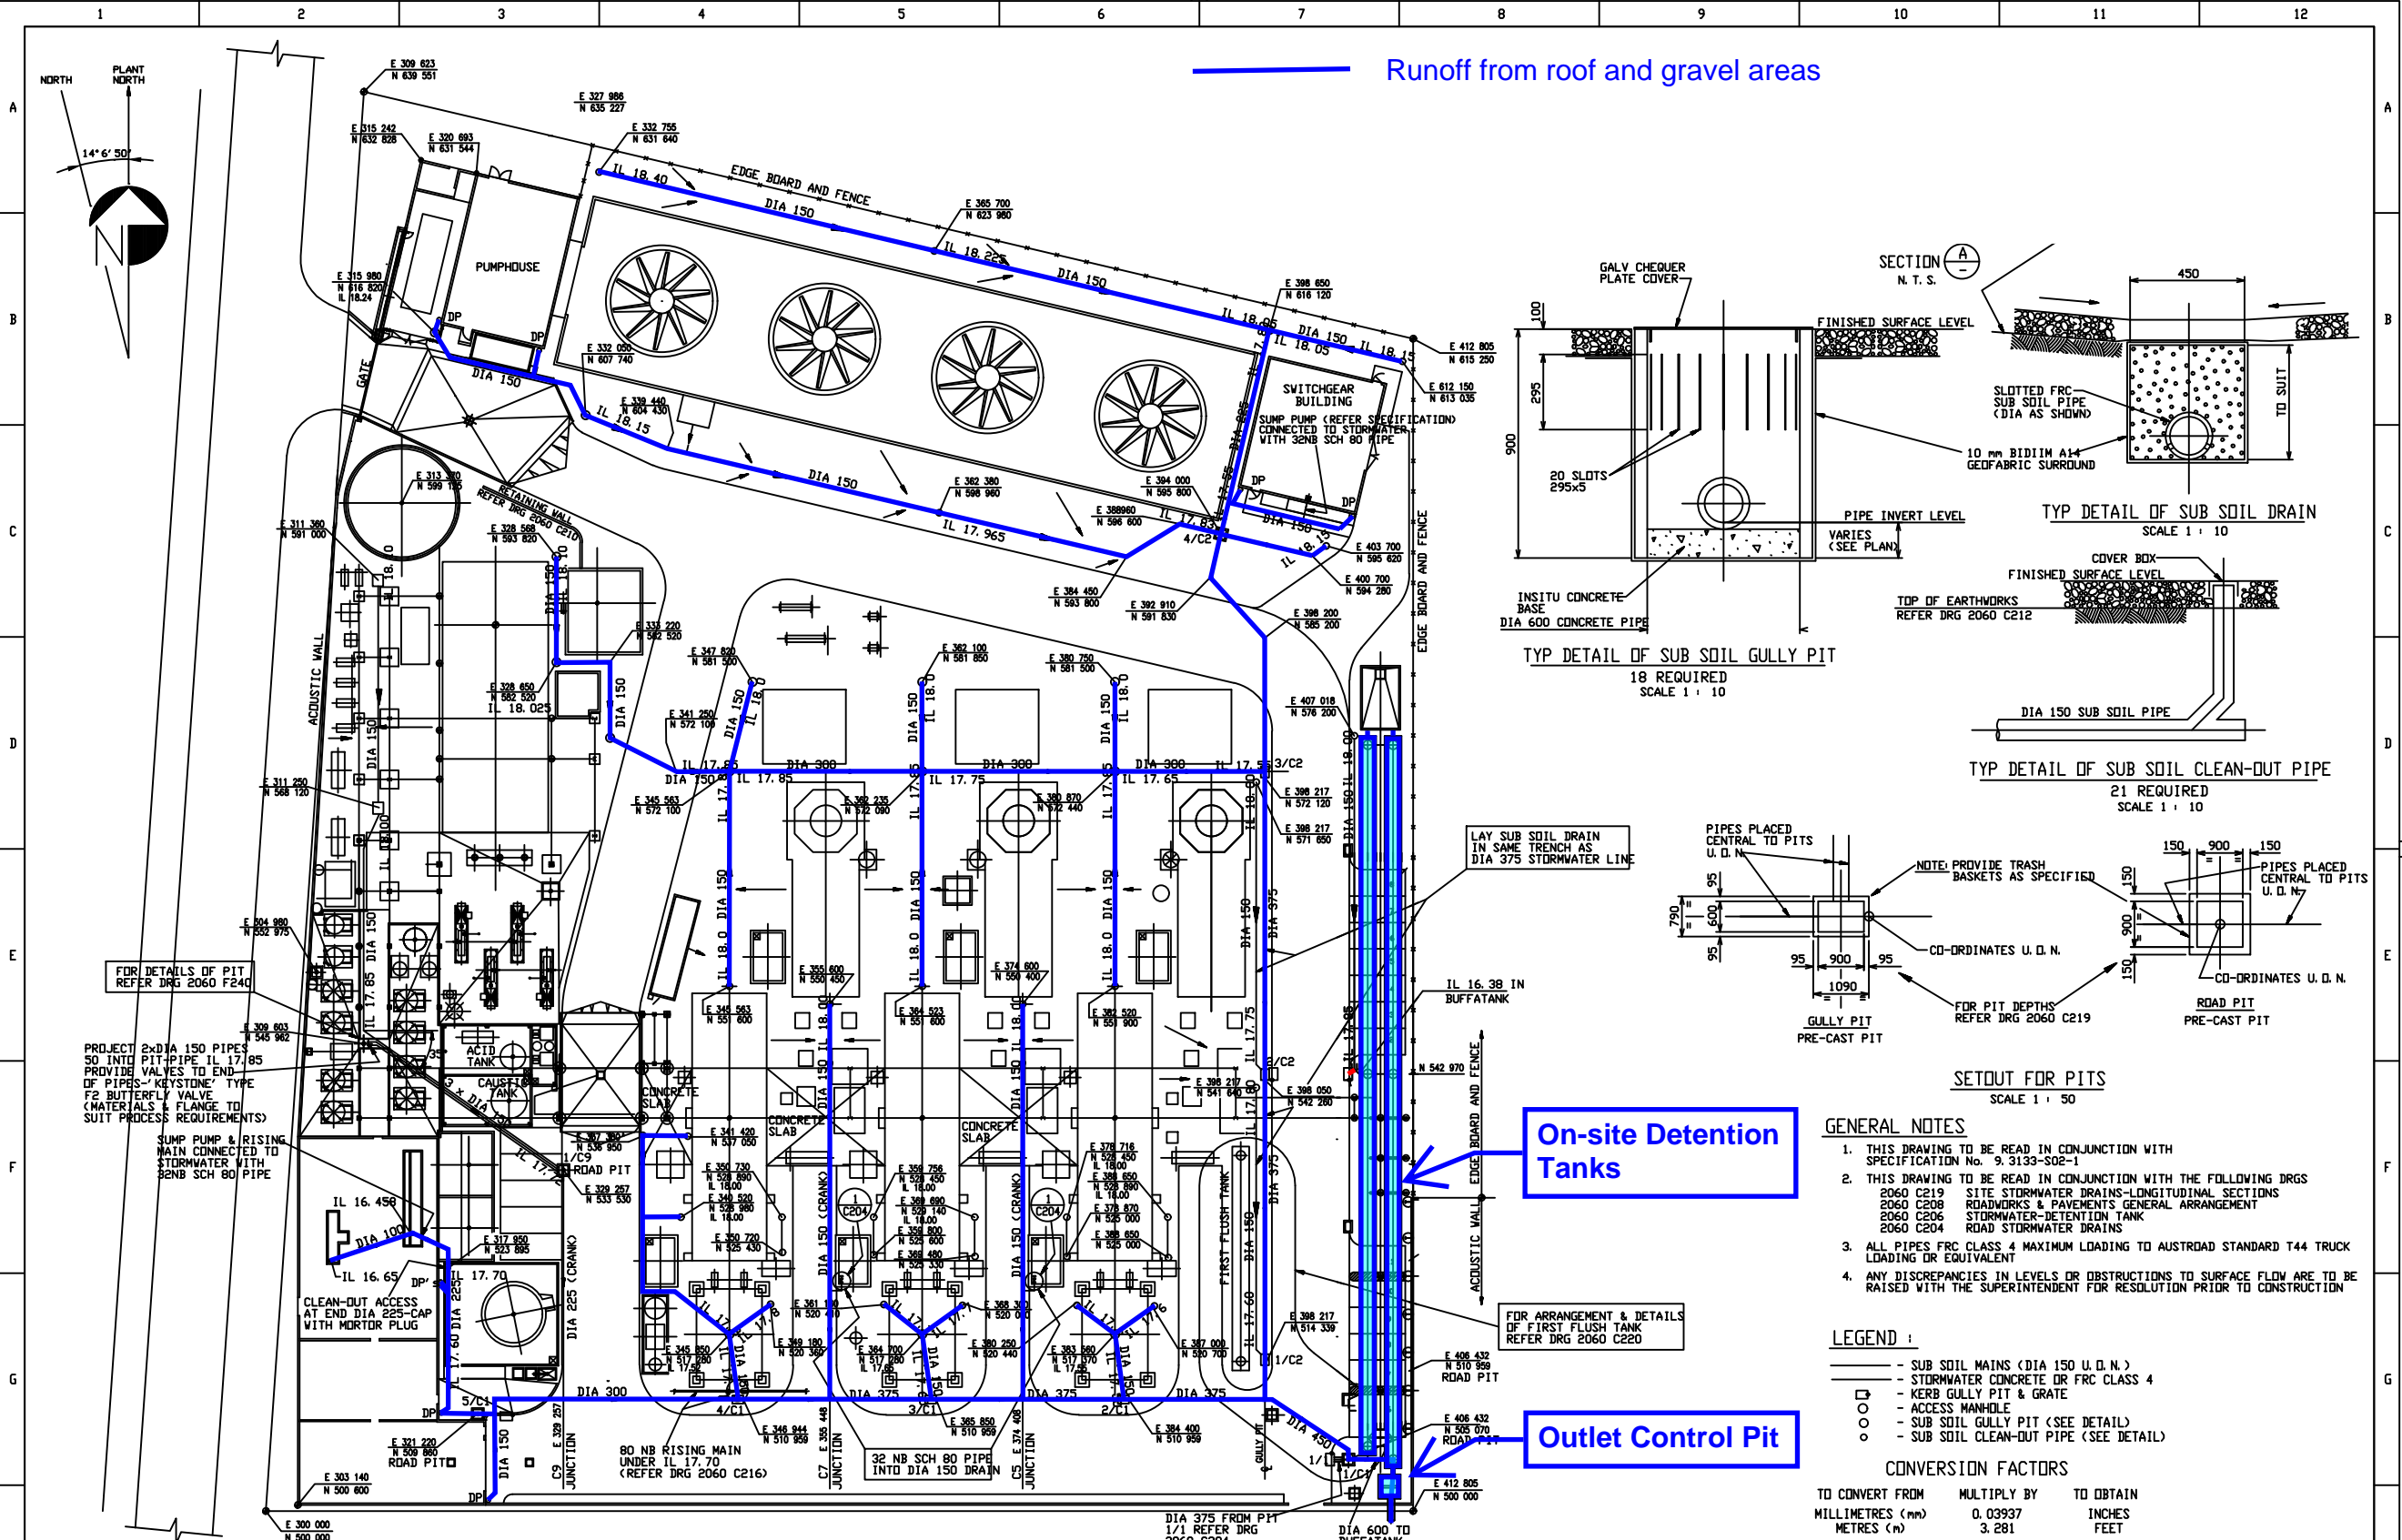

- GENERAL NOTES**
- THIS DRAWING TO BE READ IN CONJUNCTION WITH SPECIFICATION No. 9.3133-S02-1
  - THIS DRAWING TO BE READ IN CONJUNCTION WITH THE FOLLOWING DRGS  
2060 C219 SITE STORMWATER DRAINS-LONGITUDINAL SECTIONS  
2060 C208 ROADWORKS & PAVEMENTS GENERAL ARRANGEMENT  
2060 C206 STORMWATER-RETENTION TANK  
2060 C204 ROAD STORMWATER DRAINS
  - ALL PIPES FRC CLASS 4 MAXIMUM LOADING TO AUSTRAD STANDARD T44 TRUCK LOADING OR EQUIVALENT
  - ANY DISCREPANCIES IN LEVELS OR OBSTRUCTIONS TO SURFACE FLOW ARE TO BE RAISED WITH THE SUPERINTENDENT FOR RESOLUTION PRIOR TO CONSTRUCTION

- LEGEND :**
- SUB SOIL MAINS (DIA 150 U.D.N.)
  - STORMWATER CONCRETE DR FRC CLASS 4
  - KERB GULLY PIT & GRATE
  - ACCESS MANHOLE
  - SUB SOIL GULLY PIT (SEE DETAIL)
  - SUB SOIL CLEAN-OUT PIPE (SEE DETAIL)

**CONVERSION FACTORS**

TO CONVERT FROM	MULTIPLY BY	TO OBTAIN
MILLIMETRES (mm)	0.03937	INCHES
METRES (m)	3.281	FEET

REV.	DATE	DRN	CHKD	DESIGNED	VERIFIED	DESCRIPTION
D	21-1-97	B.F.S.	BFS/HA	-	-	T.S. AS BUILT
C	31-5-96	B.F.S.	J. DICKSON	J. DICKSON	R. BINNS	T. NOETEL HOLD REMOVED M/GATE & H/STD. DCN49 & 59 ADDED. HOLD ADDED. APPROVED FOR CONSTR.
B	1-4-96	B.F.S.	J. DICKSON	J. DICKSON	R. BINNS	R. STEELE ROADS REVISED AS PER DCN45. DRAINS REVISED AS PER DCN49. RE-ISSUED FOR APPROVAL.
A	23-2-96	D. TIERNEY	J. DICKSON	J. DICKSON	R. BINNS	R. STEELE APPROVED FOR CONSTRUCTION DCN32.
3	16-2-96	D. TIERNEY	J. DICKSON	J. DICKSON	R. BINNS	R. STEELE RE-ISSUED FOR APPROVAL.
D	5-10-95	D. TIERNEY	J. DICKSON	J. DICKSON	H. AGUERO	ISSUED FOR APPROVAL.

**NOTES**

- DIMENSIONS IN MILLIMETRES
- DRAWING PRACTICE TO AS 1100

**REVISIONS**

NO.	DESCRIPTION
1	AS BUILT





SCALE 1 : 250

THIS DRAWING AND DESIGN IS THE PROPERTY OF TRANSFIELD CONSTRUCTION PTY. LTD. A.C.N. 000 854 688. IT MUST NOT BE COPIED OR REPRODUCED IN ANY WAY WHATSOEVER AND/OR PASSED ON TO ANY THIRD PARTY WITHOUT WRITTEN AUTHORITY FROM TRANSFIELD CONSTRUCTION PTY. LTD. 100 ARTHUR STREET, NORTH SYDNEY 2060, N.S.W. AUSTRALIA. TEL: (02) 959 8600, FAX: (02) 954 0538

**SMITHFIELD ENERGY FACILITY**  
**SMITHFIELD, N.S.W. AUSTRALIA**  
**SITE STORMWATER DRAINS**  
**GENERAL ARRANGEMENT**

DRG NO. **2060 C213**  
SHEET 1/1  
B1

——— Runoff from road surfaces  
——— Runoff from steam turbine area, washdown areas and bunded areas

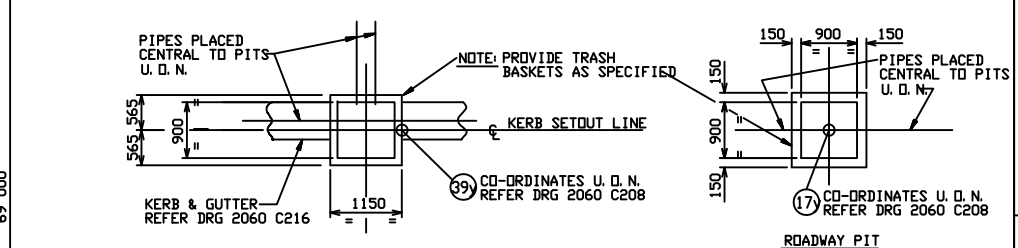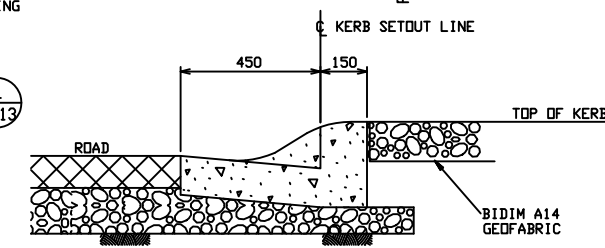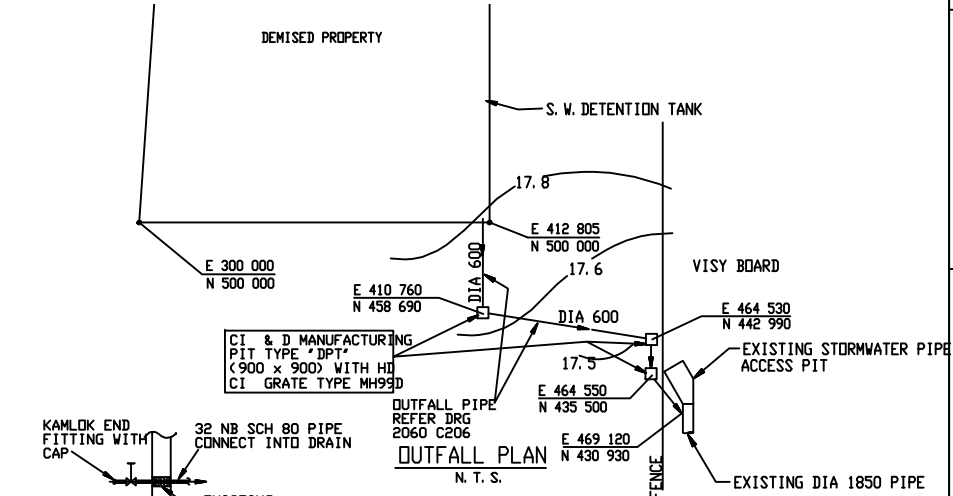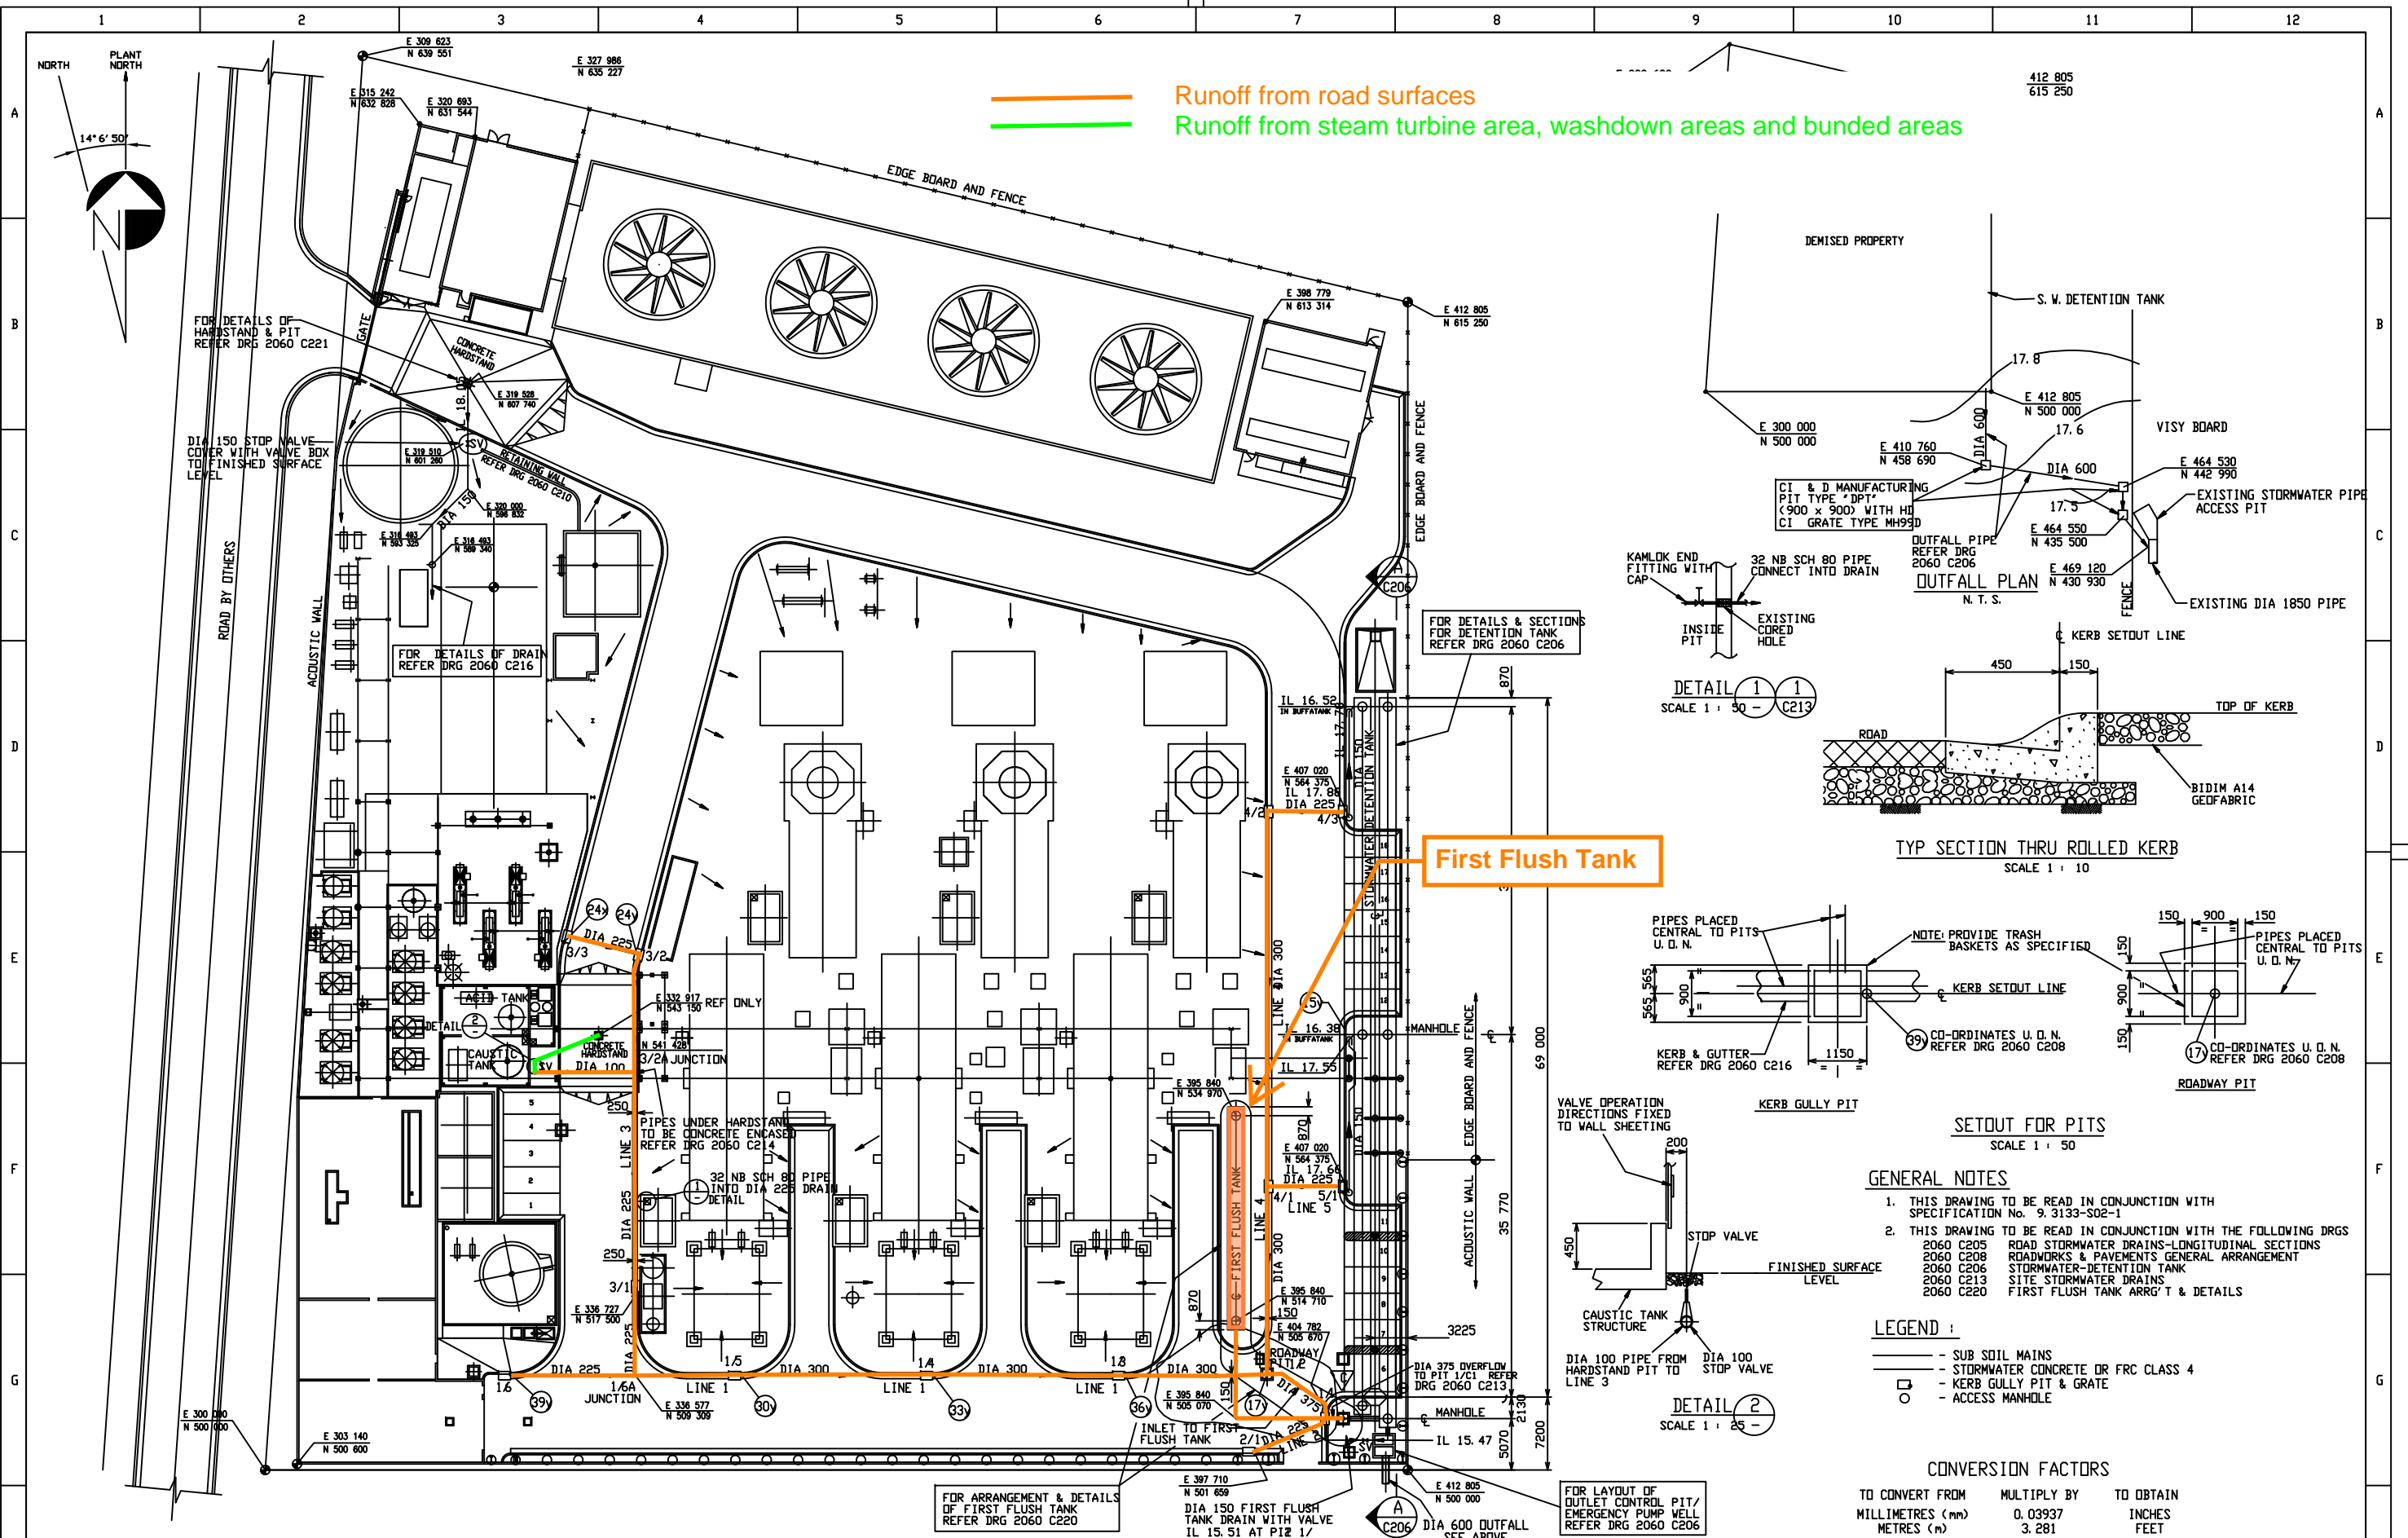

- GENERAL NOTES**
- THIS DRAWING TO BE READ IN CONJUNCTION WITH SPECIFICATION No. 9.3133-S02-1
  - THIS DRAWING TO BE READ IN CONJUNCTION WITH THE FOLLOWING DRGS:
    - 2060 C205 ROAD STORMWATER DRAINS-LONGITUDINAL SECTIONS
    - 2060 C208 ROADWORKS & PAVEMENTS GENERAL ARRANGEMENT
    - 2060 C206 STORMWATER-DETENTION TANK
    - 2060 C213 SITE STORMWATER DRAINS
    - 2060 C220 FIRST FLUSH TANK ARR'G'T & DETAILS

- LEGEND :**
- SUB SOIL MAINS
  - STORMWATER CONCRETE OR FRC CLASS 4
  - KERB GULLY PIT & GRATE
  - ACCESS MANHOLE

**CONVERSION FACTORS**

TO CONVERT FROM	MULTIPLY BY	TO OBTAIN
MILLIMETRES (mm)	0.03937	INCHES
METRES (m)	3.281	FEET

REV.	DATE	DRN	CHKD	DESIGNED	VERIFIED	DRG DES MANAGER	DESCRIPTION
D	21-1-97	B.F.S.	BFS/PA	-	-	T.S.	AS BUILT
C	30-5-96	B.F.S.	J. DICKSON	J. DICKSON	R. BINNS	T. MOETEL	REV'D. TO SUIT DCN 51. APPROVED FOR CONSTRUCTION
B	1-4-96	B.F.S.	J. DICKSON	J. DICKSON	R. BINNS	R. STEELE	REVISED TO SUIT DCN 45 & DCN 48. RE-ISSUED FOR APPROVAL.
A	23-2-96	D. TIERNEY	J. DICKSON	J. DICKSON	R. BINNS	R. STEELE	APPROVED FOR CONSTRUCTION
9	16-2-96	D. TIERNEY	J. DICKSON	J. DICKSON	R. BINNS	R. STEELE	RE-ISSUED FOR APPROVAL
B	20-12-95	D. TIERNEY	-	J. DICKSON	-	R. STEELE	GENERAL REVISION & RE-ISSUED FOR APPROVAL


**NOTES**

- DIMENSIONS IN MILLIMETRES
- DRAWING PRACTICE TO AS 1100




THIS DRAWING AND DESIGN IS THE PROPERTY OF TRANSFIELD CONSTRUCTION PTY. LTD. A.C.N. 000 854 688. IT MUST NOT BE COPIED OR REPRODUCED IN ANY WAY WHATSOEVER AND/OR PASSED ON TO ANY THIRD PARTY WITHOUT WRITTEN AUTHORITY FROM TRANSFIELD CONSTRUCTION PTY. LTD. 100 ARTHUR STREET, NORTH SYDNEY 2060, N.S.W. AUSTRALIA. TEL. (02) 929 8600, FAX. (02) 954 0538.

**SMITHFIELD ENERGY FACILITY**  
**SMITHFIELD, N. S. W. AUSTRALIA**  
**ROAD STORMWATER DRAINS**  
**GENERAL ARRANGEMENT**

DRG NO. **2060 C204**  
 SHEET 1/1

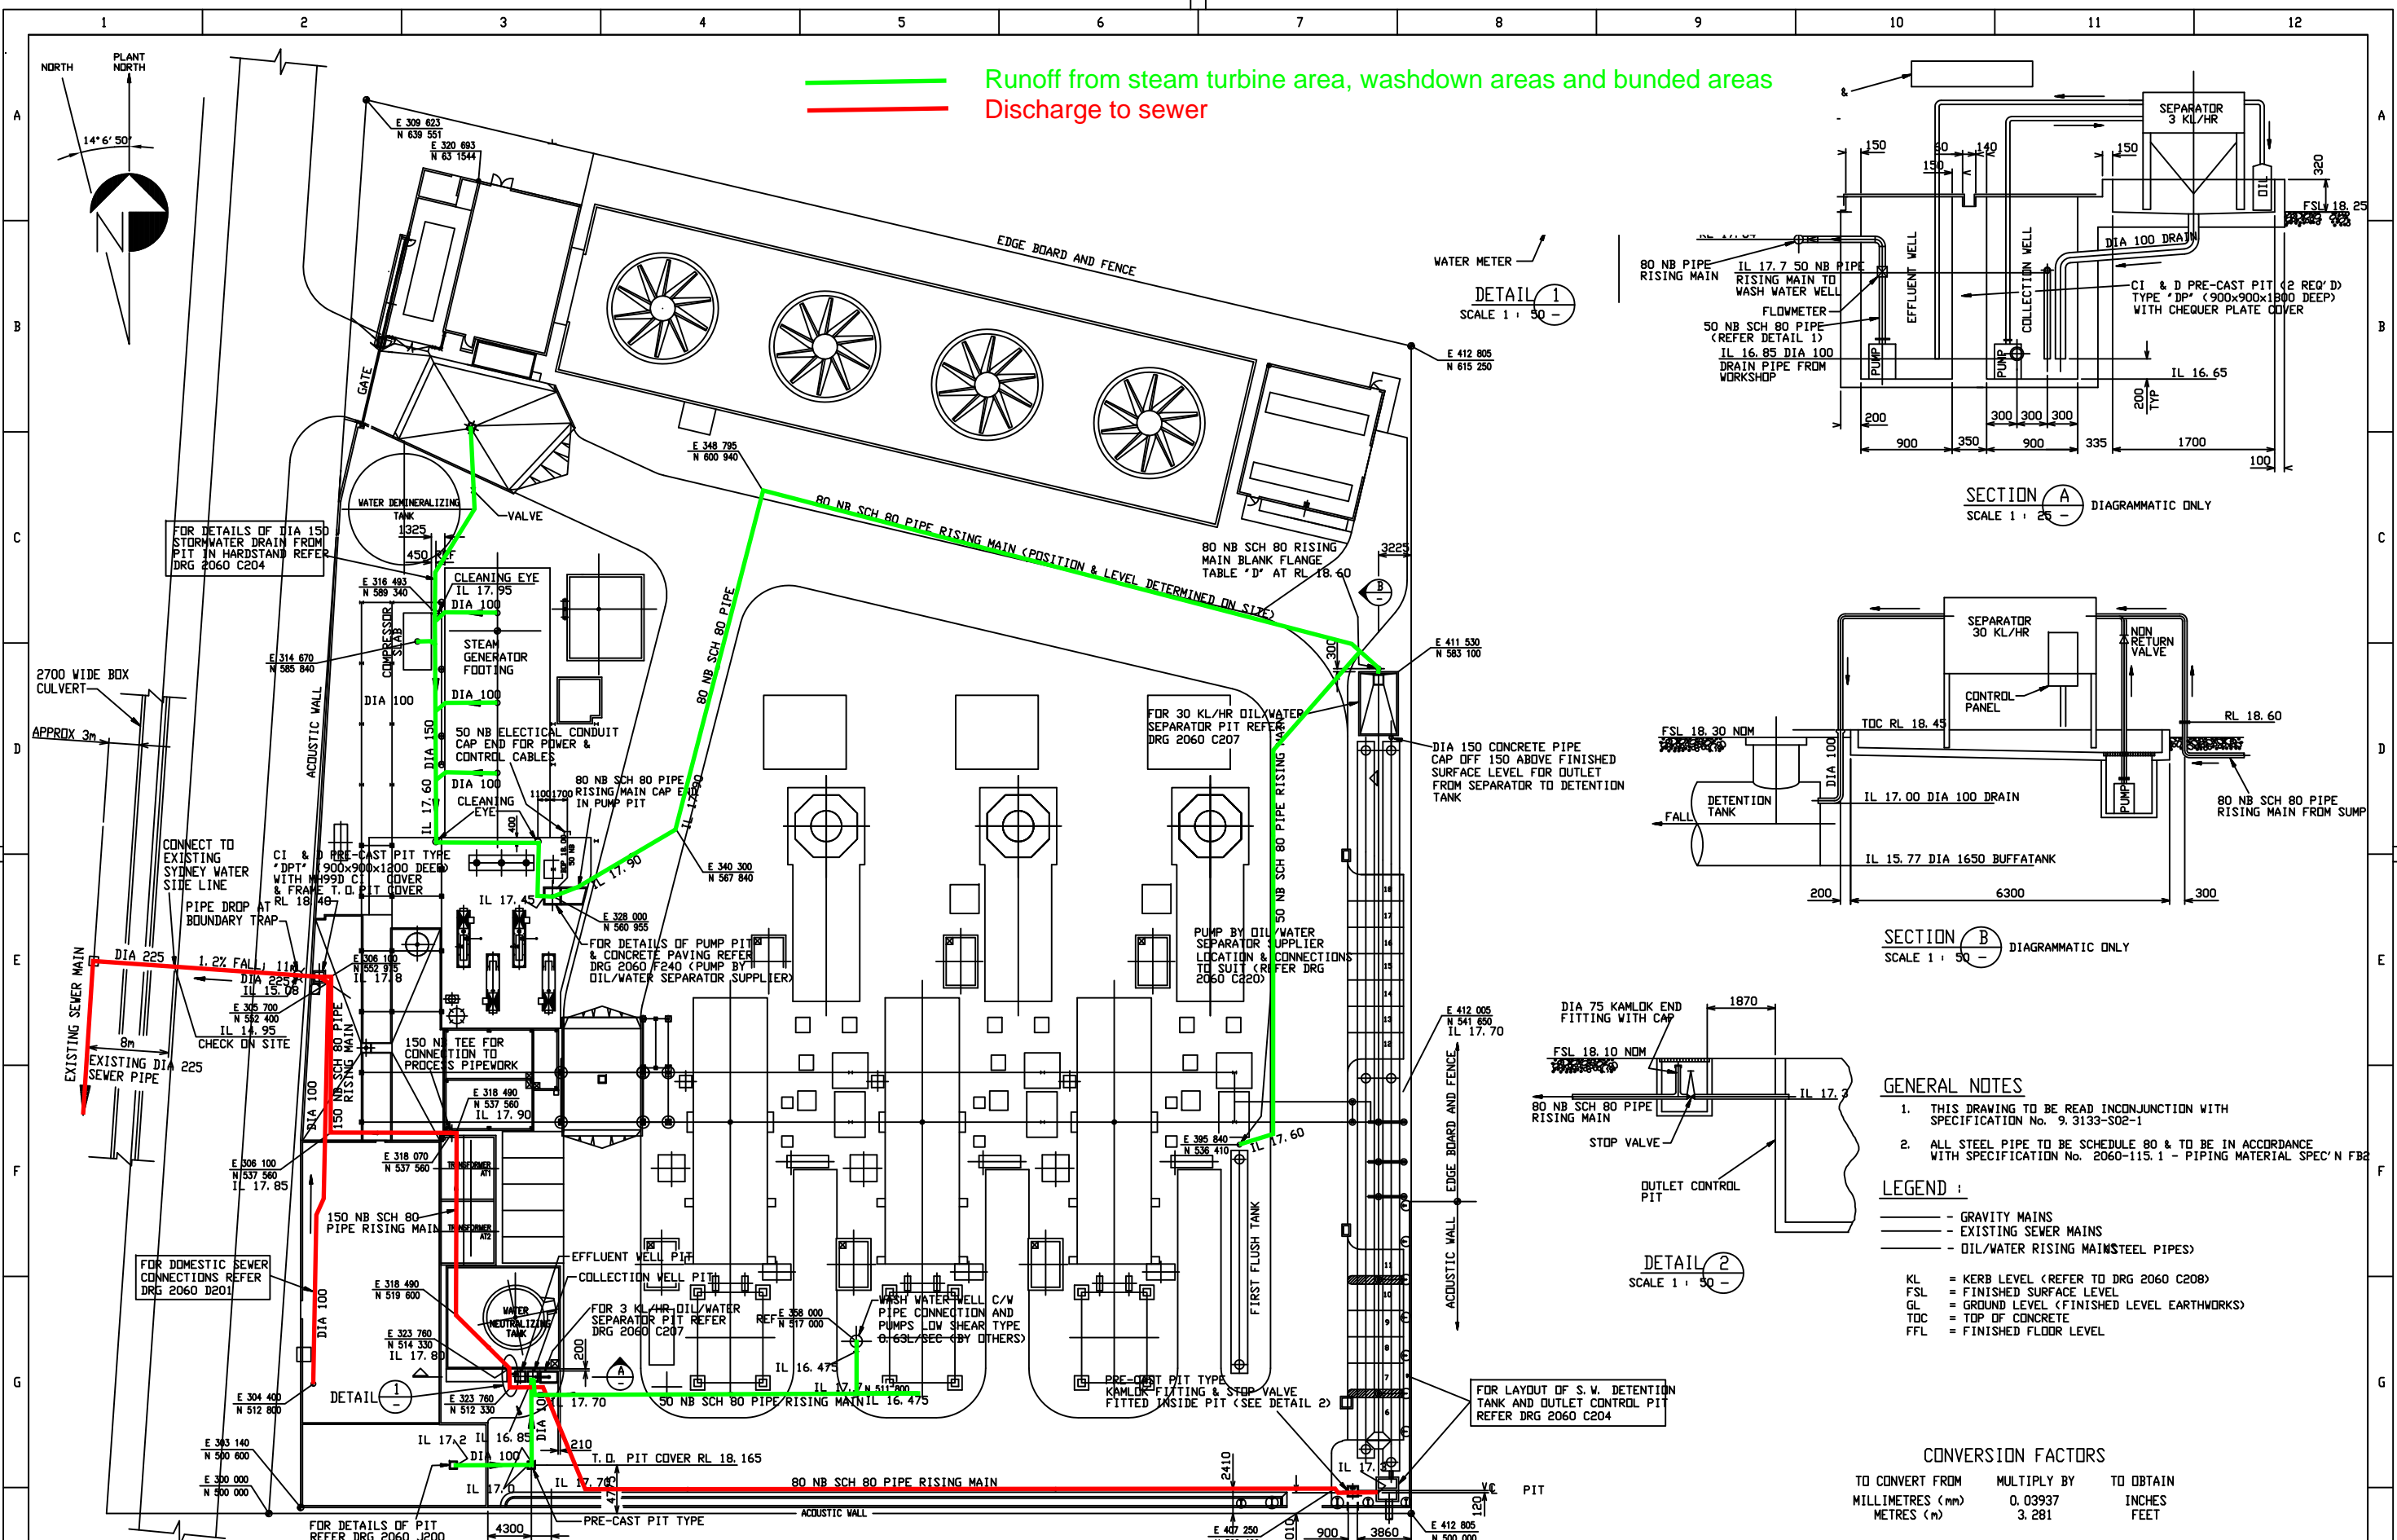

— Runoff from steam turbine area, washdown areas and bunded areas  
— Discharge to sewer

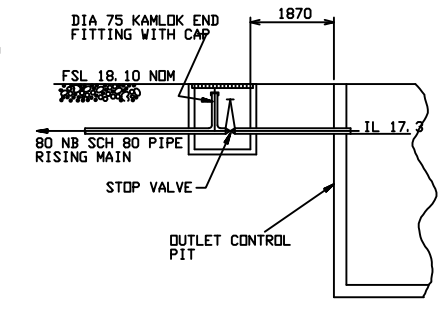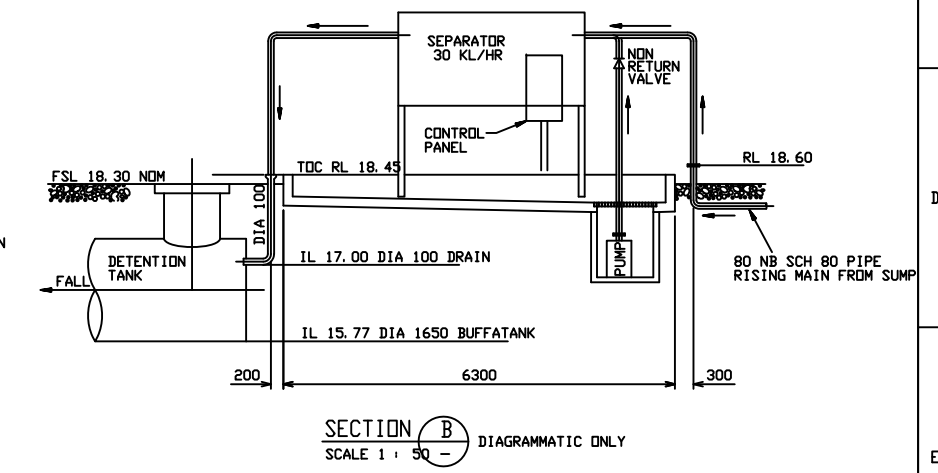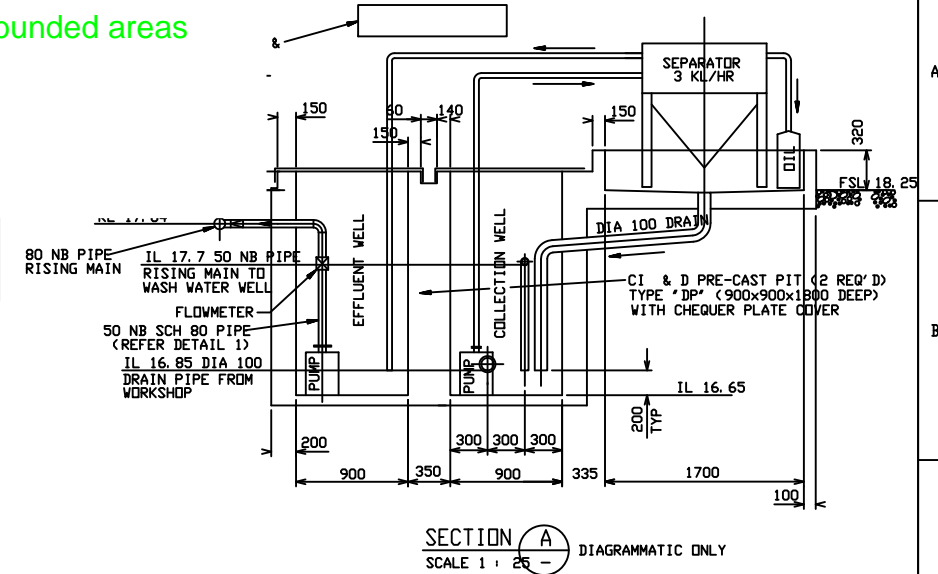

**GENERAL NOTES**

- THIS DRAWING TO BE READ INCONJUNCTION WITH SPECIFICATION No. 9.3133-S02-1
- ALL STEEL PIPE TO BE SCHEDULE 80 & TO BE IN ACCORDANCE WITH SPECIFICATION No. 2060-115.1 - PIPING MATERIAL SPEC'N FB2

**LEGEND :**

- GRAVITY MAINS
- EXISTING SEWER MAINS
- OIL/WATER RISING MAINS (STEEL PIPES)

KL = KERB LEVEL (REFER TO DRG 2060 C208)  
 FSL = FINISHED SURFACE LEVEL  
 GL = GROUND LEVEL (FINISHED LEVEL EARTHWORKS)  
 TOC = TOP OF CONCRETE  
 FFL = FINISHED FLOOR LEVEL

**CONVERSION FACTORS**

TO CONVERT FROM	MULTIPLY BY	TO OBTAIN
MILLIMETRES (mm)	0.03937	INCHES
METRES (m)	3.281	FEET

REV.	DATE	DRN	CHKD	DESIGNED	VERIFIED	ENG DES	MANAGER	DESCRIPTION
D	21-1-97	B.F.S.	BFS/HA	-	-	T.S.	-	AS BUILT
C	31-5-96	B.F.S.	J. DICKSON	J. DICKSON	R. BINNS	T. NOETEL	-	HOLD REMOVED FROM MAIN GATE, HARDSTAND, & PIT. DCN50 ADDED. APPROVED FOR CONSTRUCTION
B	1-4-96	B.F.S.	J. DICKSON	J. DICKSON	R. BINNS	R. STEELE	-	CAR PARK MODIFIED TO DCN45 & DCN46. RE-ISSUED FOR APPROVAL.
A	23-2-96	B. TIERNEY	J. DICKSON	J. DICKSON	R. BINNS	R. STEELE	-	APPROVED FOR CONSTRUCTION-VALVE PIT RELOCATED
O	5-10-95	B. TIERNEY	J. DICKSON	J. DICKSON	R. BINNS	H. AGUIERO	-	ISSUED FOR APPROVAL

**NOTES**

- DIMENSIONS IN MILLIMETRES
- DRAWING PRACTICE TO AS 1100

U. O. N.

NEPCO Transfield Joint Venture

SCALE 1 : 250

THIS DRAWING AND DESIGN IS THE PROPERTY OF TRANSFIELD CONSTRUCTION PTY. LTD. A.C.N. 000 854 688. IT MUST NOT BE COPIED OR REPRODUCED IN ANY WAY WHATSOEVER AND/OR PASSED ON TO ANY THIRD PARTY WITHOUT WRITTEN AUTHORITY FROM TRANSFIELD CONSTRUCTION PTY. LTD. 100 ARTHUR STREET, NORTH SYDNEY 2060, N.S.W. AUSTRALIA. TEL. (02) 929 8600, FAX. (02) 954 0538


**SMITHFIELD ENERGY FACILITY**  
SMITHFIELD, N. S. W. AUSTRALIA

**SEWER RETICULATION AND OIL/WATER SEPARATORS GENERAL ARRANGEMENT**

DRG NO. **2060 C216**

SHEET 1/1

B1

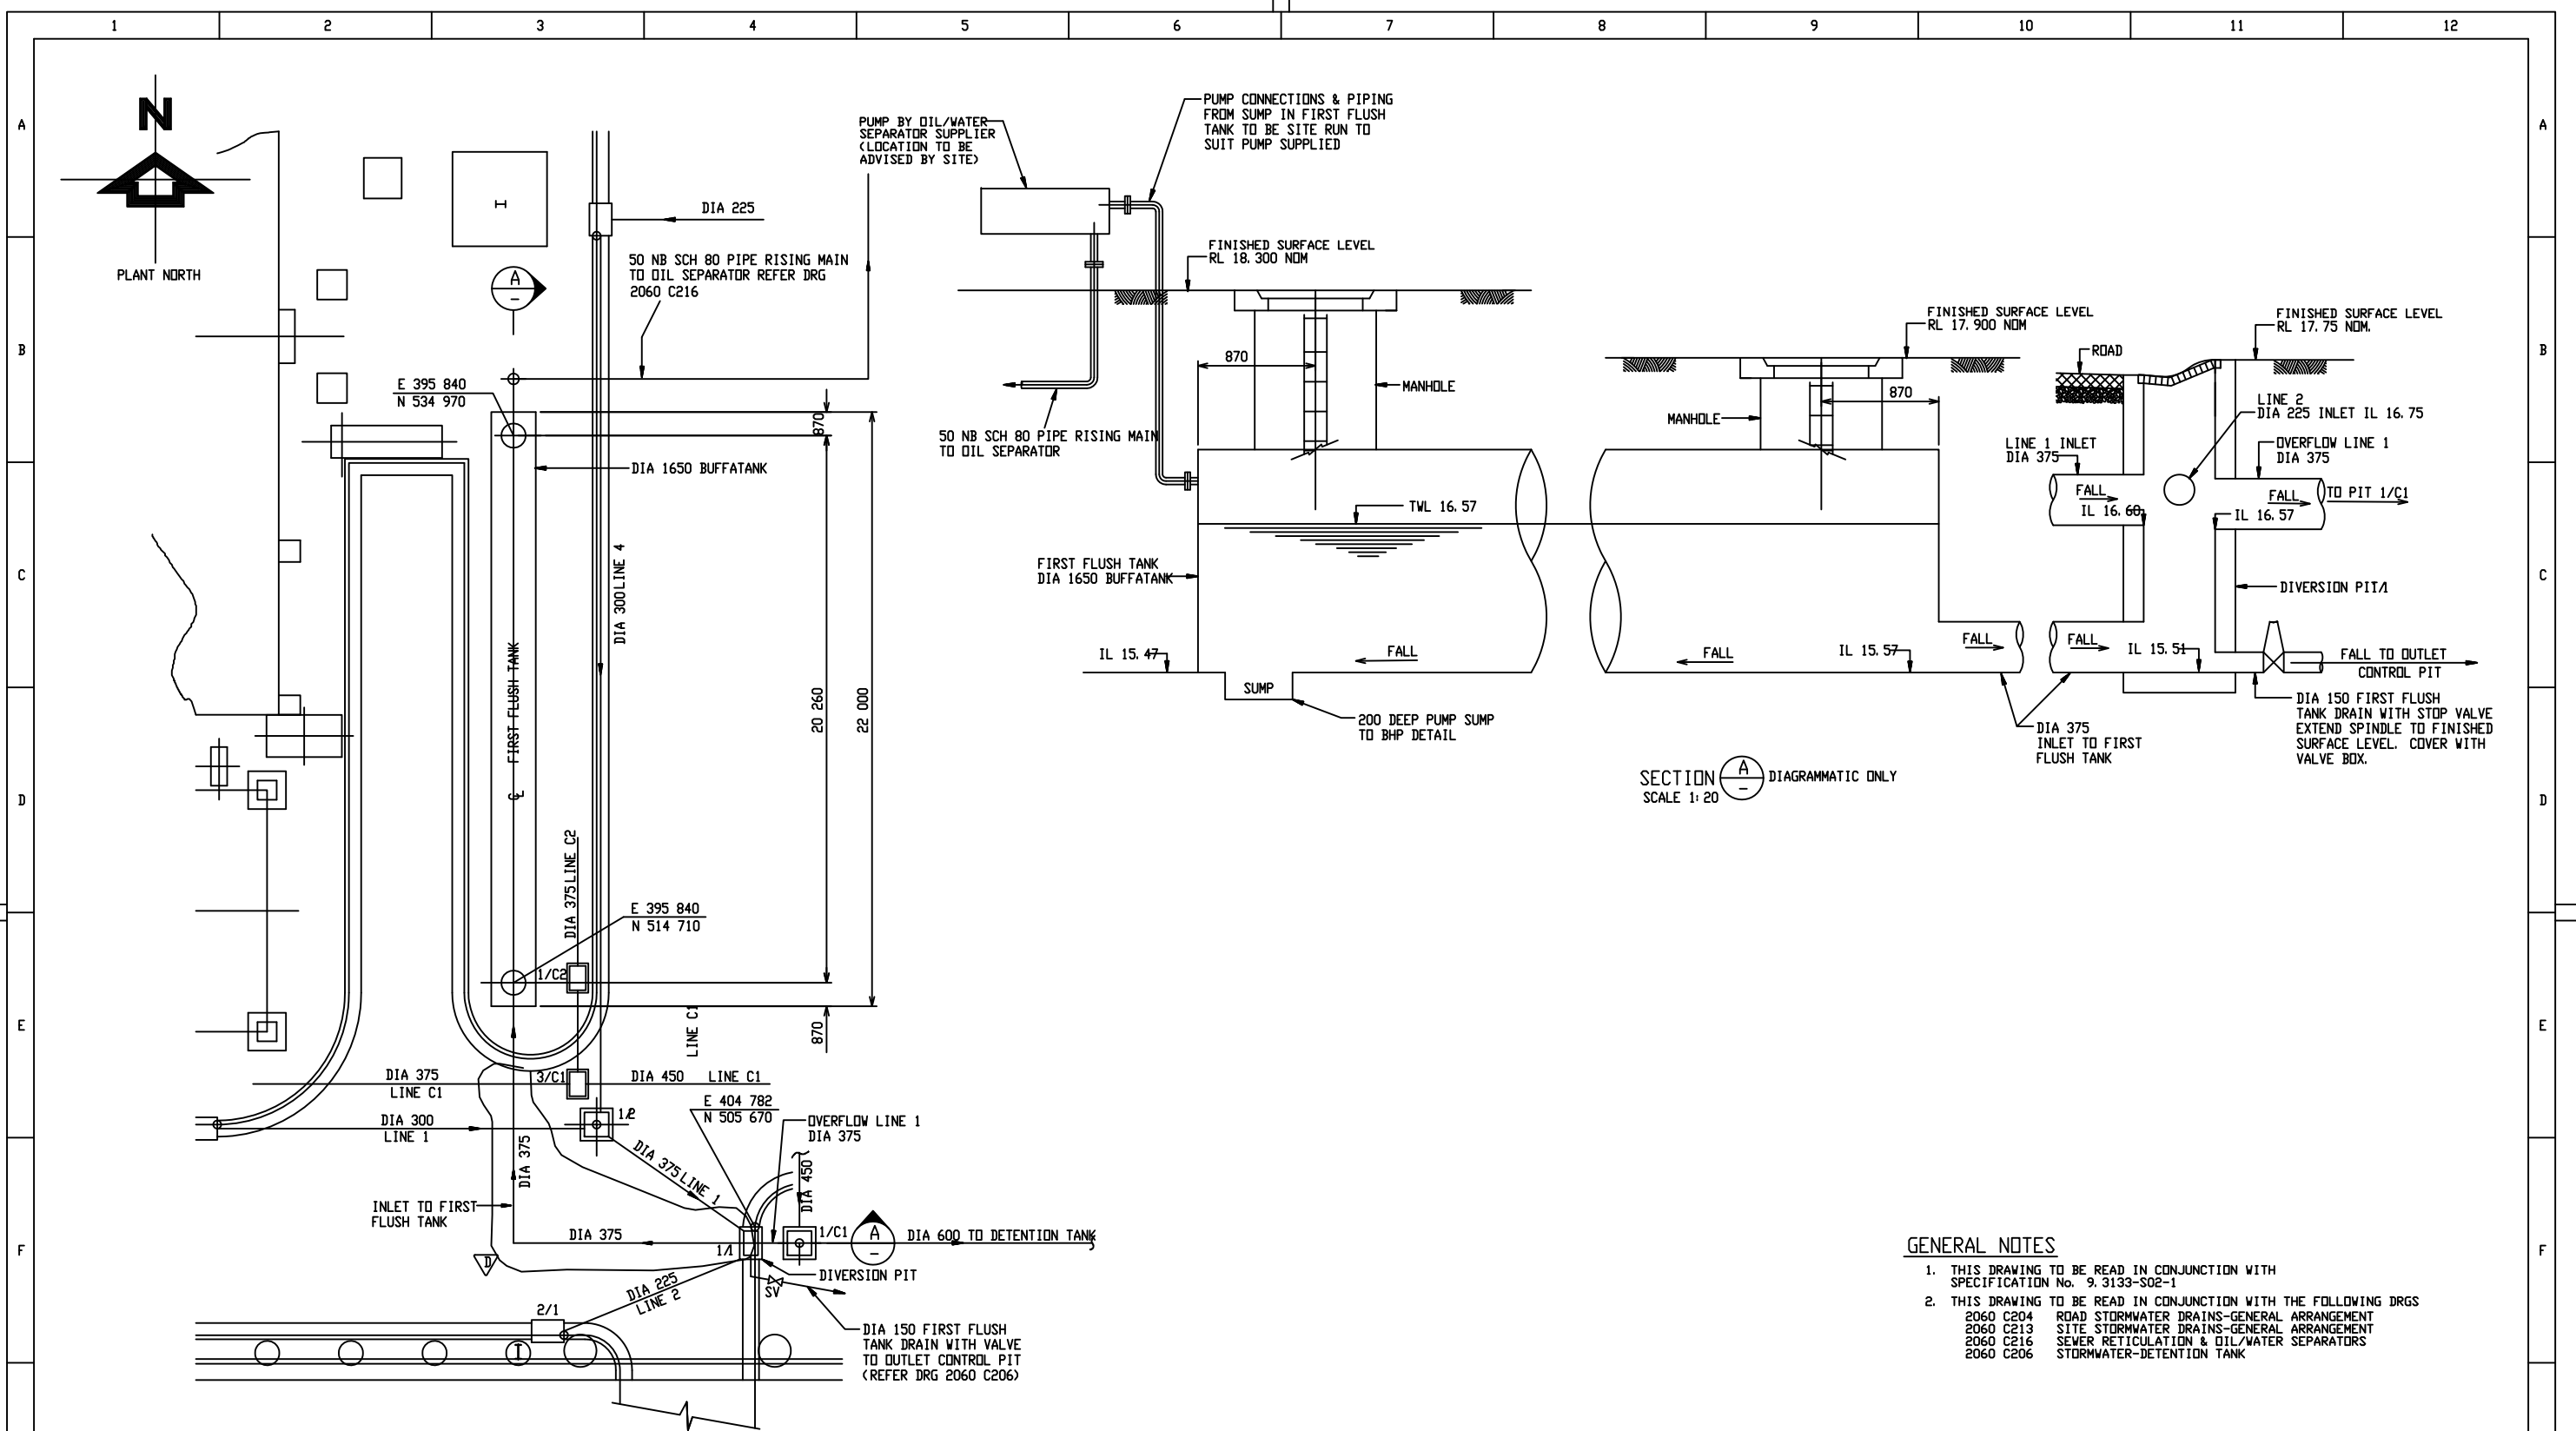

SECTION A-A DIAGRAMMATIC ONLY  
SCALE 1:20


- GENERAL NOTES**
- THIS DRAWING TO BE READ IN CONJUNCTION WITH SPECIFICATION No. 9, 3133-S02-1
  - THIS DRAWING TO BE READ IN CONJUNCTION WITH THE FOLLOWING DRGS  
 2060 C204 ROAD STORMWATER DRAINS-GENERAL ARRANGEMENT  
 2060 C213 SITE STORMWATER DRAINS-GENERAL ARRANGEMENT  
 2060 C216 SEWER RETICULATION & OIL/WATER SEPARATORS  
 2060 C206 STORMWATER-DETENTION TANK

**CONVERSION FACTORS**

TO CONVERT FROM	MULTIPLY BY	TO OBTAIN
MILLIMETRES (mm)	0.03937	INCHES
METRES (m)	3.281	FEET

REV.	DATE	DRN	CHKD	DESIGNED	VERIFIED	ENG'G DES MANAGER	DESCRIPTION
D	21-1-97	B.F.S.	BFS/WH	-	-	T.S.	AS BUILT.
C	4-6-96	B.F.S.	J. DICKSON	J. DICKSON	R. BINNS	T. METEL	APPROVED FOR CONSTRUCTION.
B	1-4-96	B.F.S.	J. DICKSON	J. DICKSON	R. BINNS	R. STEELE	REVISED AS PER DCN46. RE-ISSUED FOR APPROVAL.
A	23-2-96	B. TIERNEY	J. DICKSON	J. DICKSON	R. BINNS	R. STEELE	APPROVED FOR CONSTRUCTION
1	16-2-96	B. TIERNEY	J. DICKSON	J. DICKSON	R. BINNS	R. STEELE	RE-ISSUED FOR APPROVAL
0	20-12-95	B. TIERNEY	J. DICKSON	J. DICKSON	R. BINNS	R. STEELE	ISSUED FOR APPROVAL

**NOTES**  
 1. DIMENSIONS IN MILLIMETRES  
 2. DRAWING PRACTICE TO AS 1100

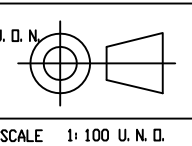


THIS DRAWING AND DESIGN IS THE PROPERTY OF TRANSFIELD CONSTRUCTION PTY. LTD.  
 A.C.N. 000 954 688  
 IT MUST NOT BE COPIED OR REPRODUCED IN ANY WAY WHATSOEVER AND/OR PASSED ON TO ANY THIRD PARTY WITHOUT WRITTEN AUTHORITY FROM TRANSFIELD CONSTRUCTION PTY. LTD.  
 100 ARTHUR STREET,  
 NORTH SYDNEY 2060, N.S.W. AUSTRALIA  
 TEL. (02) 929 8600, FAX. (02) 954 0538

SMITHFIELD ENERGY FACILITY  
 SMITHFIELD, N.S.W. AUSTRALIA  
 SITE DRAINAGE STORMWATER  
 FIRST FLUSH TANK  
 ARRANGEMENT & DETAILS

DRG NO.	2060 C220
SHEET 1 /	
B1	WEST



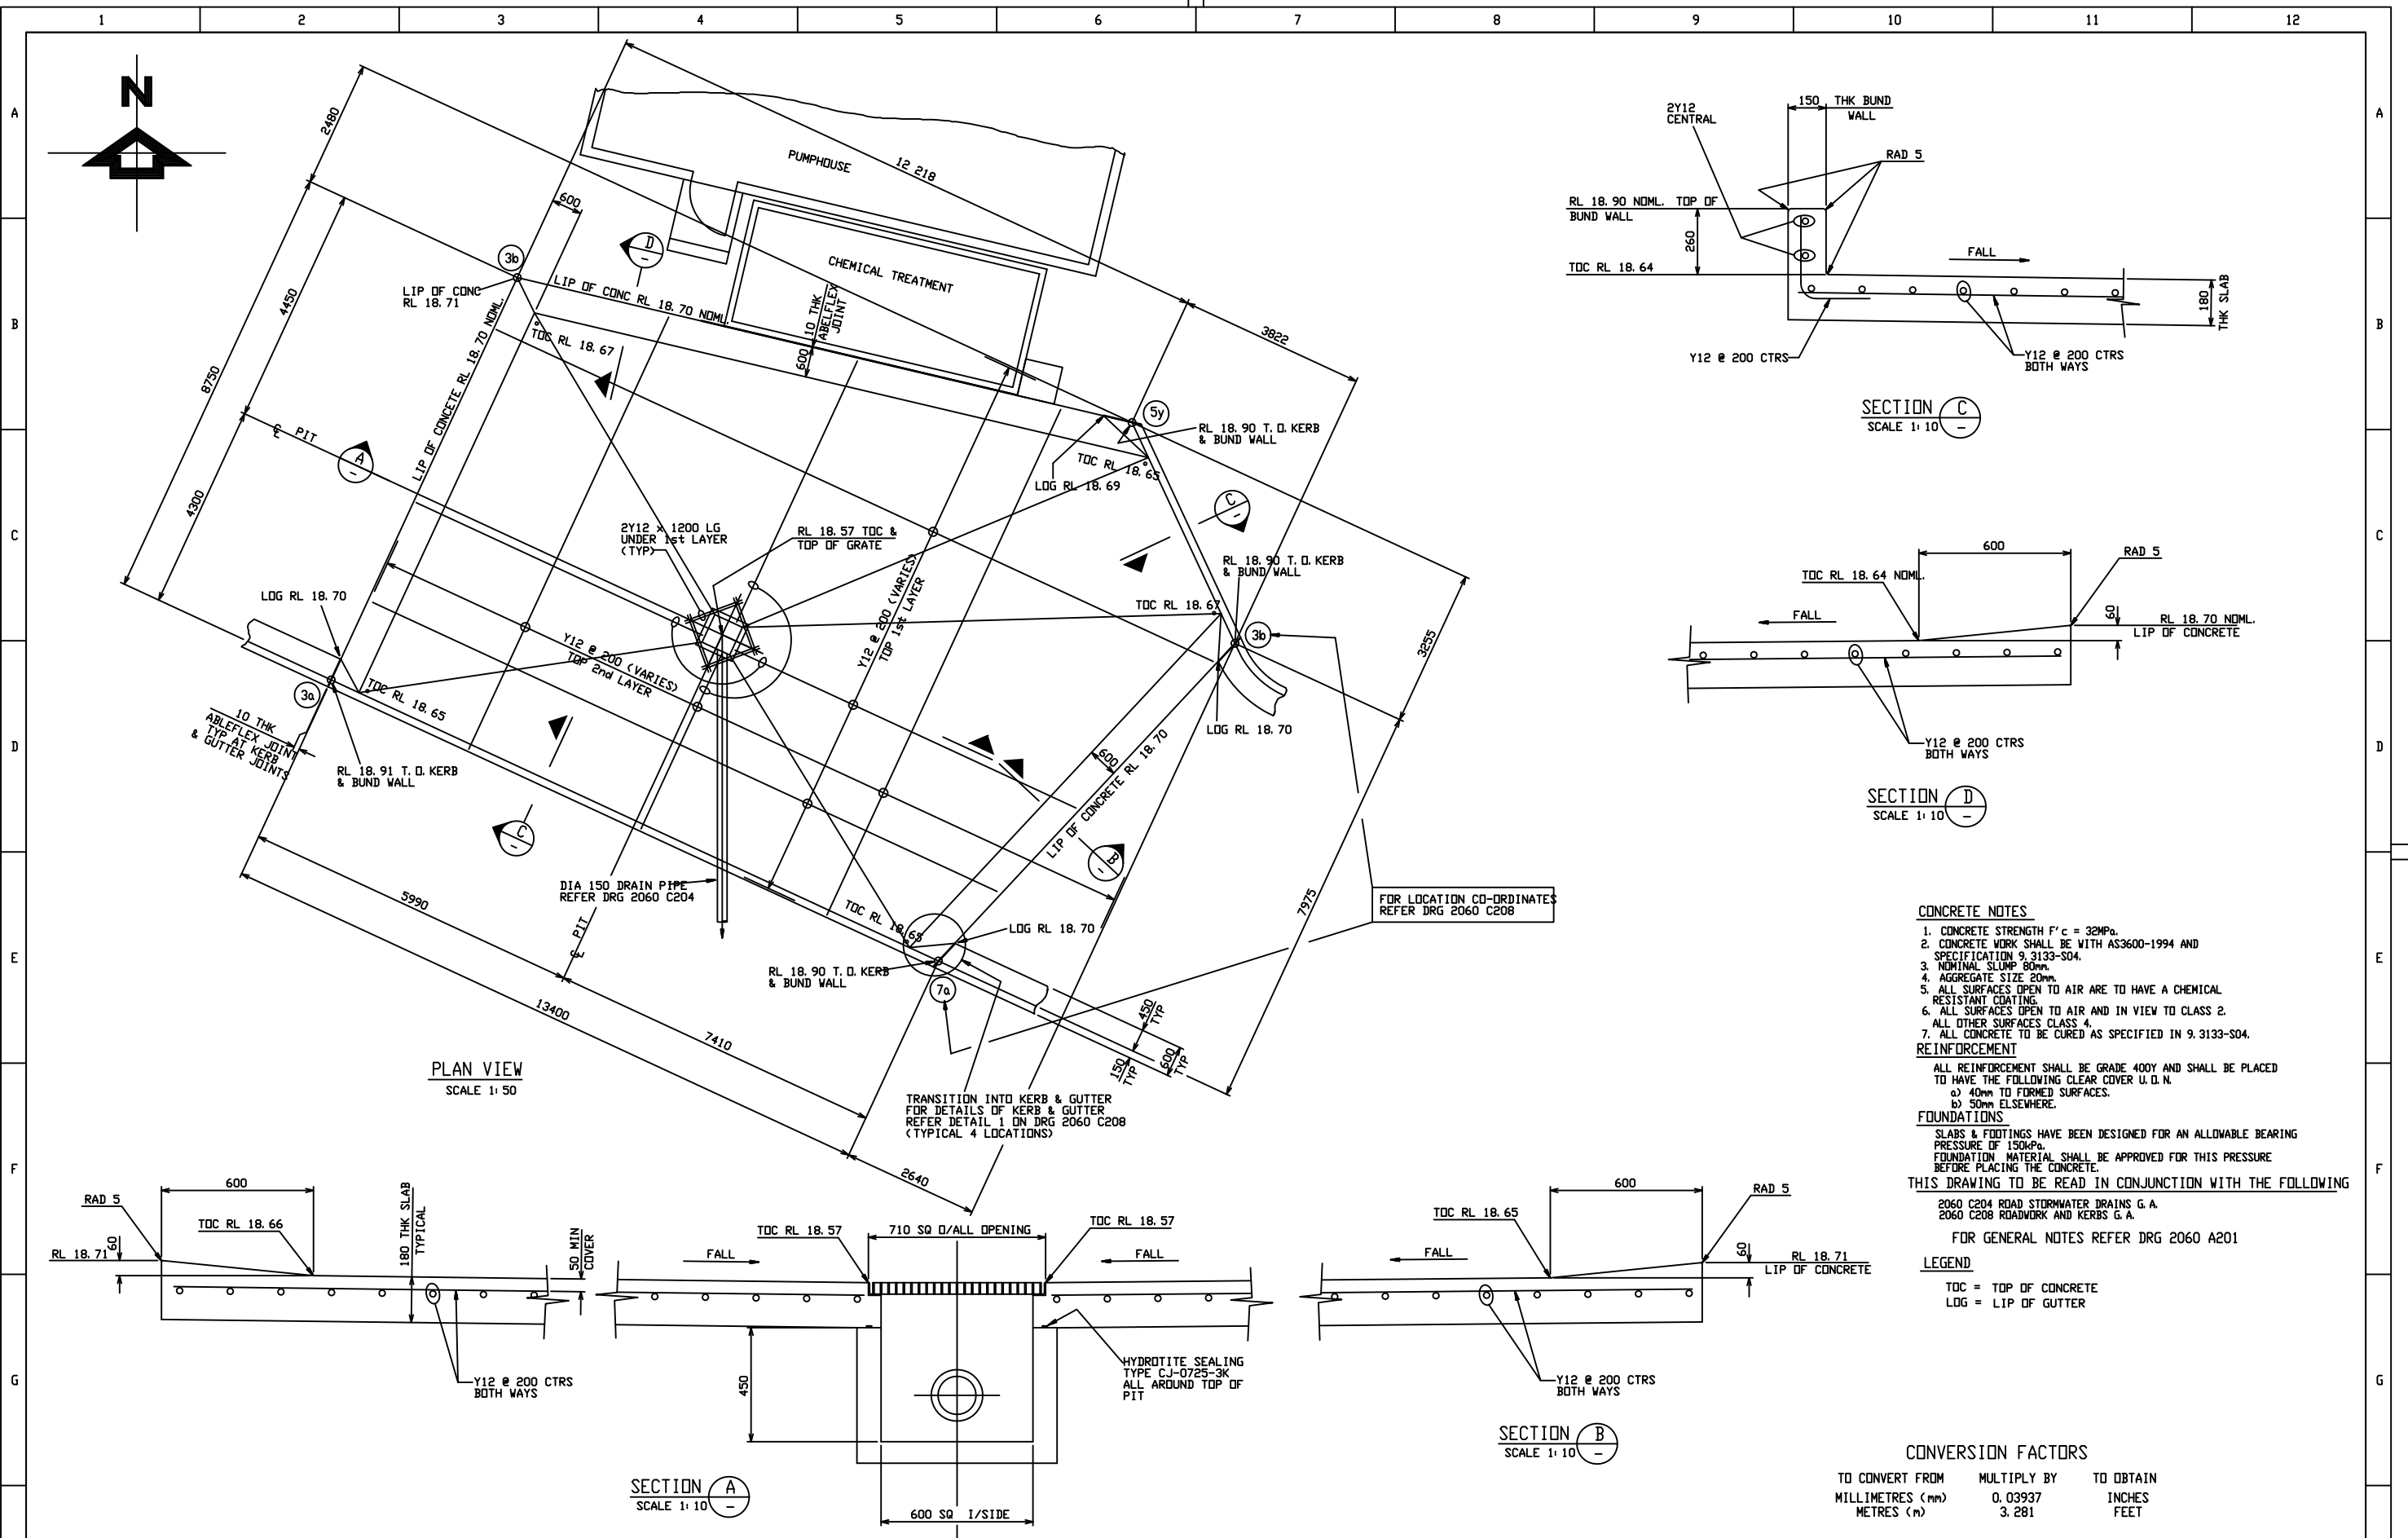

**CONCRETE NOTES**

1. CONCRETE STRENGTH  $f'c = 32\text{MPa}$ .
2. CONCRETE WORK SHALL BE WITH AS3600-1994 AND SPECIFICATION 9.3133-S04.
3. NOMINAL SLUMP 80mm.
4. AGGREGATE SIZE 20mm.
5. ALL SURFACES OPEN TO AIR ARE TO HAVE A CHEMICAL RESISTANT COATING.
6. ALL SURFACES OPEN TO AIR AND IN VIEW TO CLASS 2. ALL OTHER SURFACES CLASS 4.
7. ALL CONCRETE TO BE CURED AS SPECIFIED IN 9.3133-S04.

**REINFORCEMENT**

ALL REINFORCEMENT SHALL BE GRADE 400Y AND SHALL BE PLACED TO HAVE THE FOLLOWING CLEAR COVER U.D.N.

- a) 40mm TO FORMED SURFACES.
- b) 50mm ELSEWHERE.

**FOUNDATIONS**

SLABS & FOOTINGS HAVE BEEN DESIGNED FOR AN ALLOWABLE BEARING PRESSURE OF 150kPa.

FOUNDATION MATERIAL SHALL BE APPROVED FOR THIS PRESSURE BEFORE PLACING THE CONCRETE.

THIS DRAWING TO BE READ IN CONJUNCTION WITH THE FOLLOWING

2060 C204 ROAD STORMWATER DRAINS G.A.  
2060 C208 ROADWORK AND KERBS G.A.

FOR GENERAL NOTES REFER DRG 2060 A201

**LEGEND**


TDC = TOP OF CONCRETE  
LOG = LIP OF GUTTER

**CONVERSION FACTORS**

TO CONVERT FROM	MULTIPLY BY	TO OBTAIN
MILLIMETRES (mm)	0.03937	INCHES
METRES (m)	3.281	FEET

REV.	DATE	DRN	CHKD	DESIGNED	VERIFIED	ENG. DES. MANAGER	DESCRIPTION
B	21-1-97	BFS	BFS/HA	-	-	T.S.	AS BUILT
A	11-9-96	B. TIERNEY	B. F. S.	J. DIXON	R. BINNS	R. STEELE	APPROVED FOR CONSTRUCTION
0	23-2-96	B. TIERNEY	B. F. S.	J. DIXON	R. BINNS	R. STEELE	ISSUED FOR APPROVAL


NOTES
1. DIMENSIONS IN MILLIMETRES
2. DRAWING PRACTICE TO AS 1100

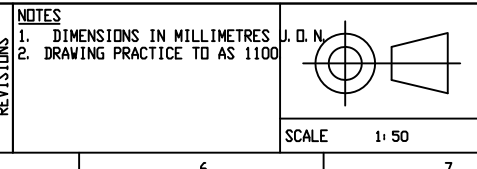

THIS DRAWING AND DESIGN IS THE PROPERTY OF TRANSFIELD CONSTRUCTION PTY. LTD.  
A.C.N. 000 854 688  
IT MUST NOT BE COPIED OR REPRODUCED IN ANY WAY WHATSOEVER AND/OR PASSED ON TO ANY THIRD PARTY WITHOUT WRITTEN AUTHORITY FROM TRANSFIELD CONSTRUCTION PTY. LTD.  
100 ARTHUR STREET,  
NORTH SYDNEY 2060, N.S.W. AUSTRALIA  
TEL. (02) 929 8600, FAX. (02) 954 0538


SMITHFIELD ENERGY FACILITY  
SMITHFIELD, N.S.W. AUSTRALIA  
CONCRETE HARDSTAND AT  
PUMPHOUSE - DETAILS

DRG NO.	2060 C221
SHEET 1/1	
B1	

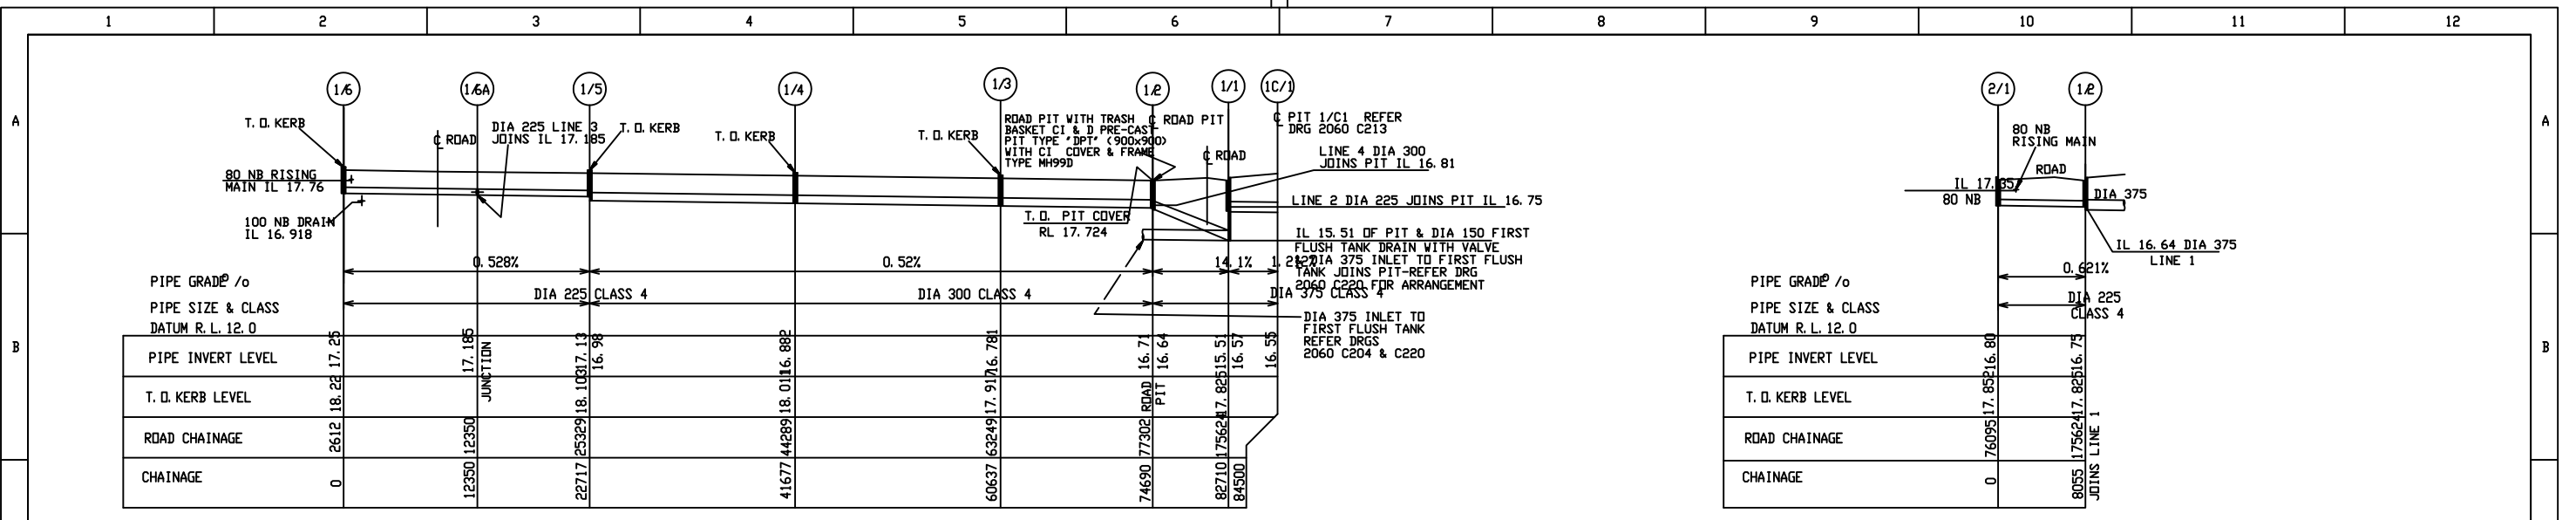


STORMWATER DRAINAGE LONGITUDINAL SECTION - LINE 1

STORMWATER DRAINAGE LONGITUDINAL SECTION - LINE 2

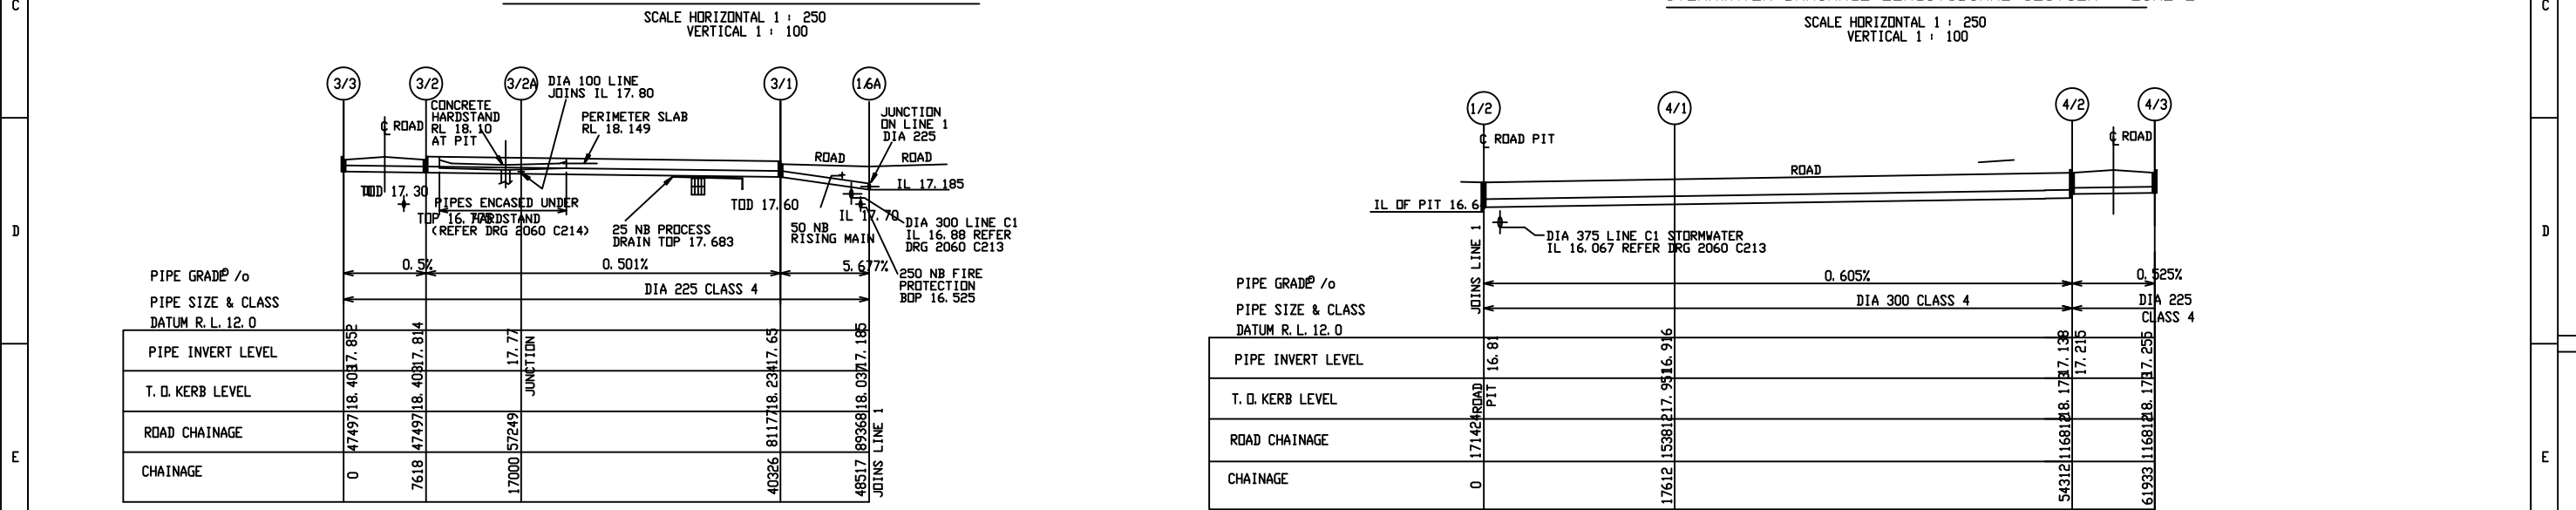


STORMWATER DRAINAGE LONGITUDINAL SECTION - LINE 3

STORMWATER DRAINAGE LONGITUDINAL SECTION - LINE 4

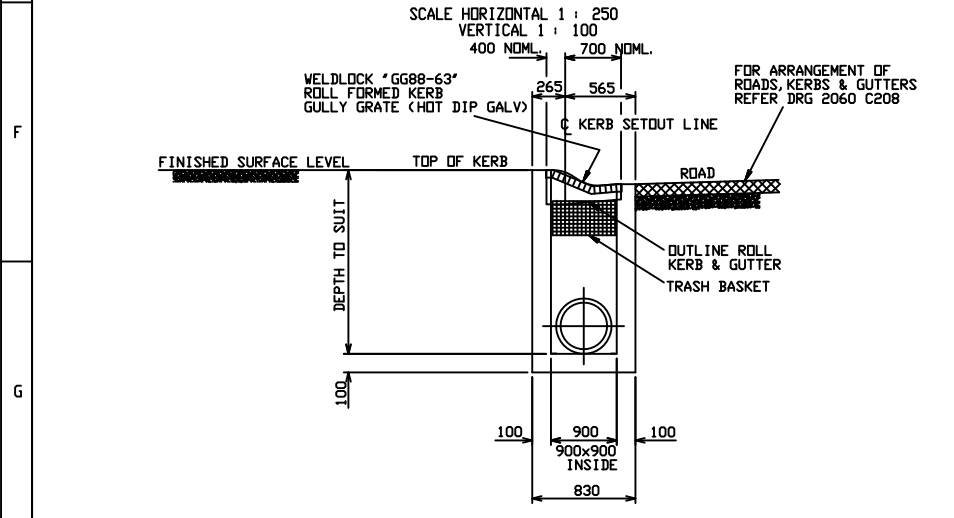

TYP SECTION THRU KERB GULLY PIT  
SCALE 1 : 25

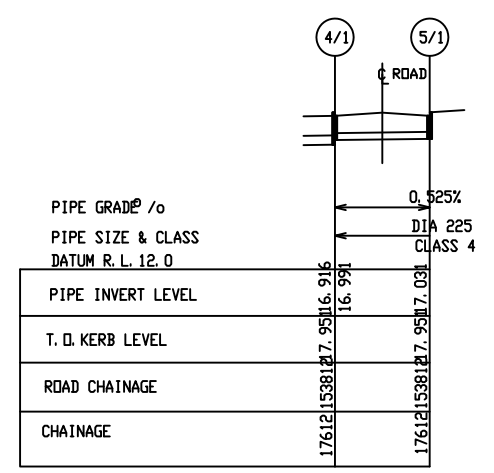

STORMWATER DRAINAGE LONGITUDINAL SECTION - LINE 5

**GENERAL NOTES**  
THIS DRAWING TO BE READ IN CONJUNCTION WITH SPECIFICATION No. 9.3133-S02-1

**NOMENCLATURE :** TOD : TOP OF DUCT  
TOP : TOP OF PIPE  
BOP : BOTTOM OF PIPE

**CONVERSION FACTORS**  
TO CONVERT FROM MILLIMETRES (mm) METRES (m) MULTIPLY BY 0.03937 3.281 TO OBTAIN INCHES FEET

THIS DRAWING TO BE READ IN CONJUNCTION WITH DRG 2060 C204

REV.	DATE	DRN	CHKD	DESIGNED	VERIFIED	ENG. DES. MANAGER	DESCRIPTION
D	21-1-97	B.F.S.	BFS/HA	-	-	T.S.	AS BUILT
C	4-6-96	B.F.S.	J. DICKSON	J. DICKSON	R. BINNS	T. NIETEL	REVISED TO DCN46. APPROVED FOR CONSTRUCTION.
B	1-4-96	B.F.S.	J. DICKSON	J. DICKSON	R. BINNS	R. STEELE	REVISED AS PER DCN48. RE-ISSUED FOR APPROVAL.
A	23-2-96	D. TIERNEY	J. DICKSON	J. DICKSON	R. BINNS	R. STEELE	APPROVED FOR CONSTRUCTION
1	16-2-96	D. TIERNEY	J. DICKSON	J. DICKSON	R. BINNS	R. STEELE	RE-ISSUED FOR APPROVAL
0	1-8-95	B.F.S.	J. DICKSON	J. DICKSON	R. BINNS	R. STEELE	ISSUED FOR APPROVAL.

REV.	DATE	DRN	CHKD	DESIGNED	VERIFIED	ENG. DES. MANAGER	DESCRIPTION
1	16-2-96	D. TIERNEY	J. DICKSON	J. DICKSON	R. BINNS	R. STEELE	RE-ISSUED FOR APPROVAL

NOTES  
1. DIMENSIONS IN MILLIMETRES  
2. DRAWING PRACTICE TO AS 1100

J. D. N.

SCALE 1 : 250

NEPCO Transfield Joint Venture


THIS DRAWING AND DESIGN IS THE PROPERTY OF TRANSFIELD CONSTRUCTION PTY. LTD. A.C.N. 000 854 688. IT MUST NOT BE COPIED OR REPRODUCED IN ANY WAY WHATSOEVER AND/OR PASSED ON TO ANY THIRD PARTY WITHOUT WRITTEN AUTHORITY FROM TRANSFIELD CONSTRUCTION PTY. LTD. 100 ARTHUR STREET, NORTH SYDNEY 2060, N.S.W. AUSTRALIA. TEL. (02) 929 8600, FAX. (02) 954 0538

SMITHFIELD ENERGY FACILITY  
SMITHFIELD, N.S.W. AUSTRALIA

ROAD STORMWATER DRAINS  
LONGITUDINAL SECTIONS

DRG NO. 2060 C205  
SHEET 11/1

B1	ISSUE	1	2	3	4	5	6	7	8	9	10	11	12
----	-------	---	---	---	---	---	---	---	---	---	----	----	----


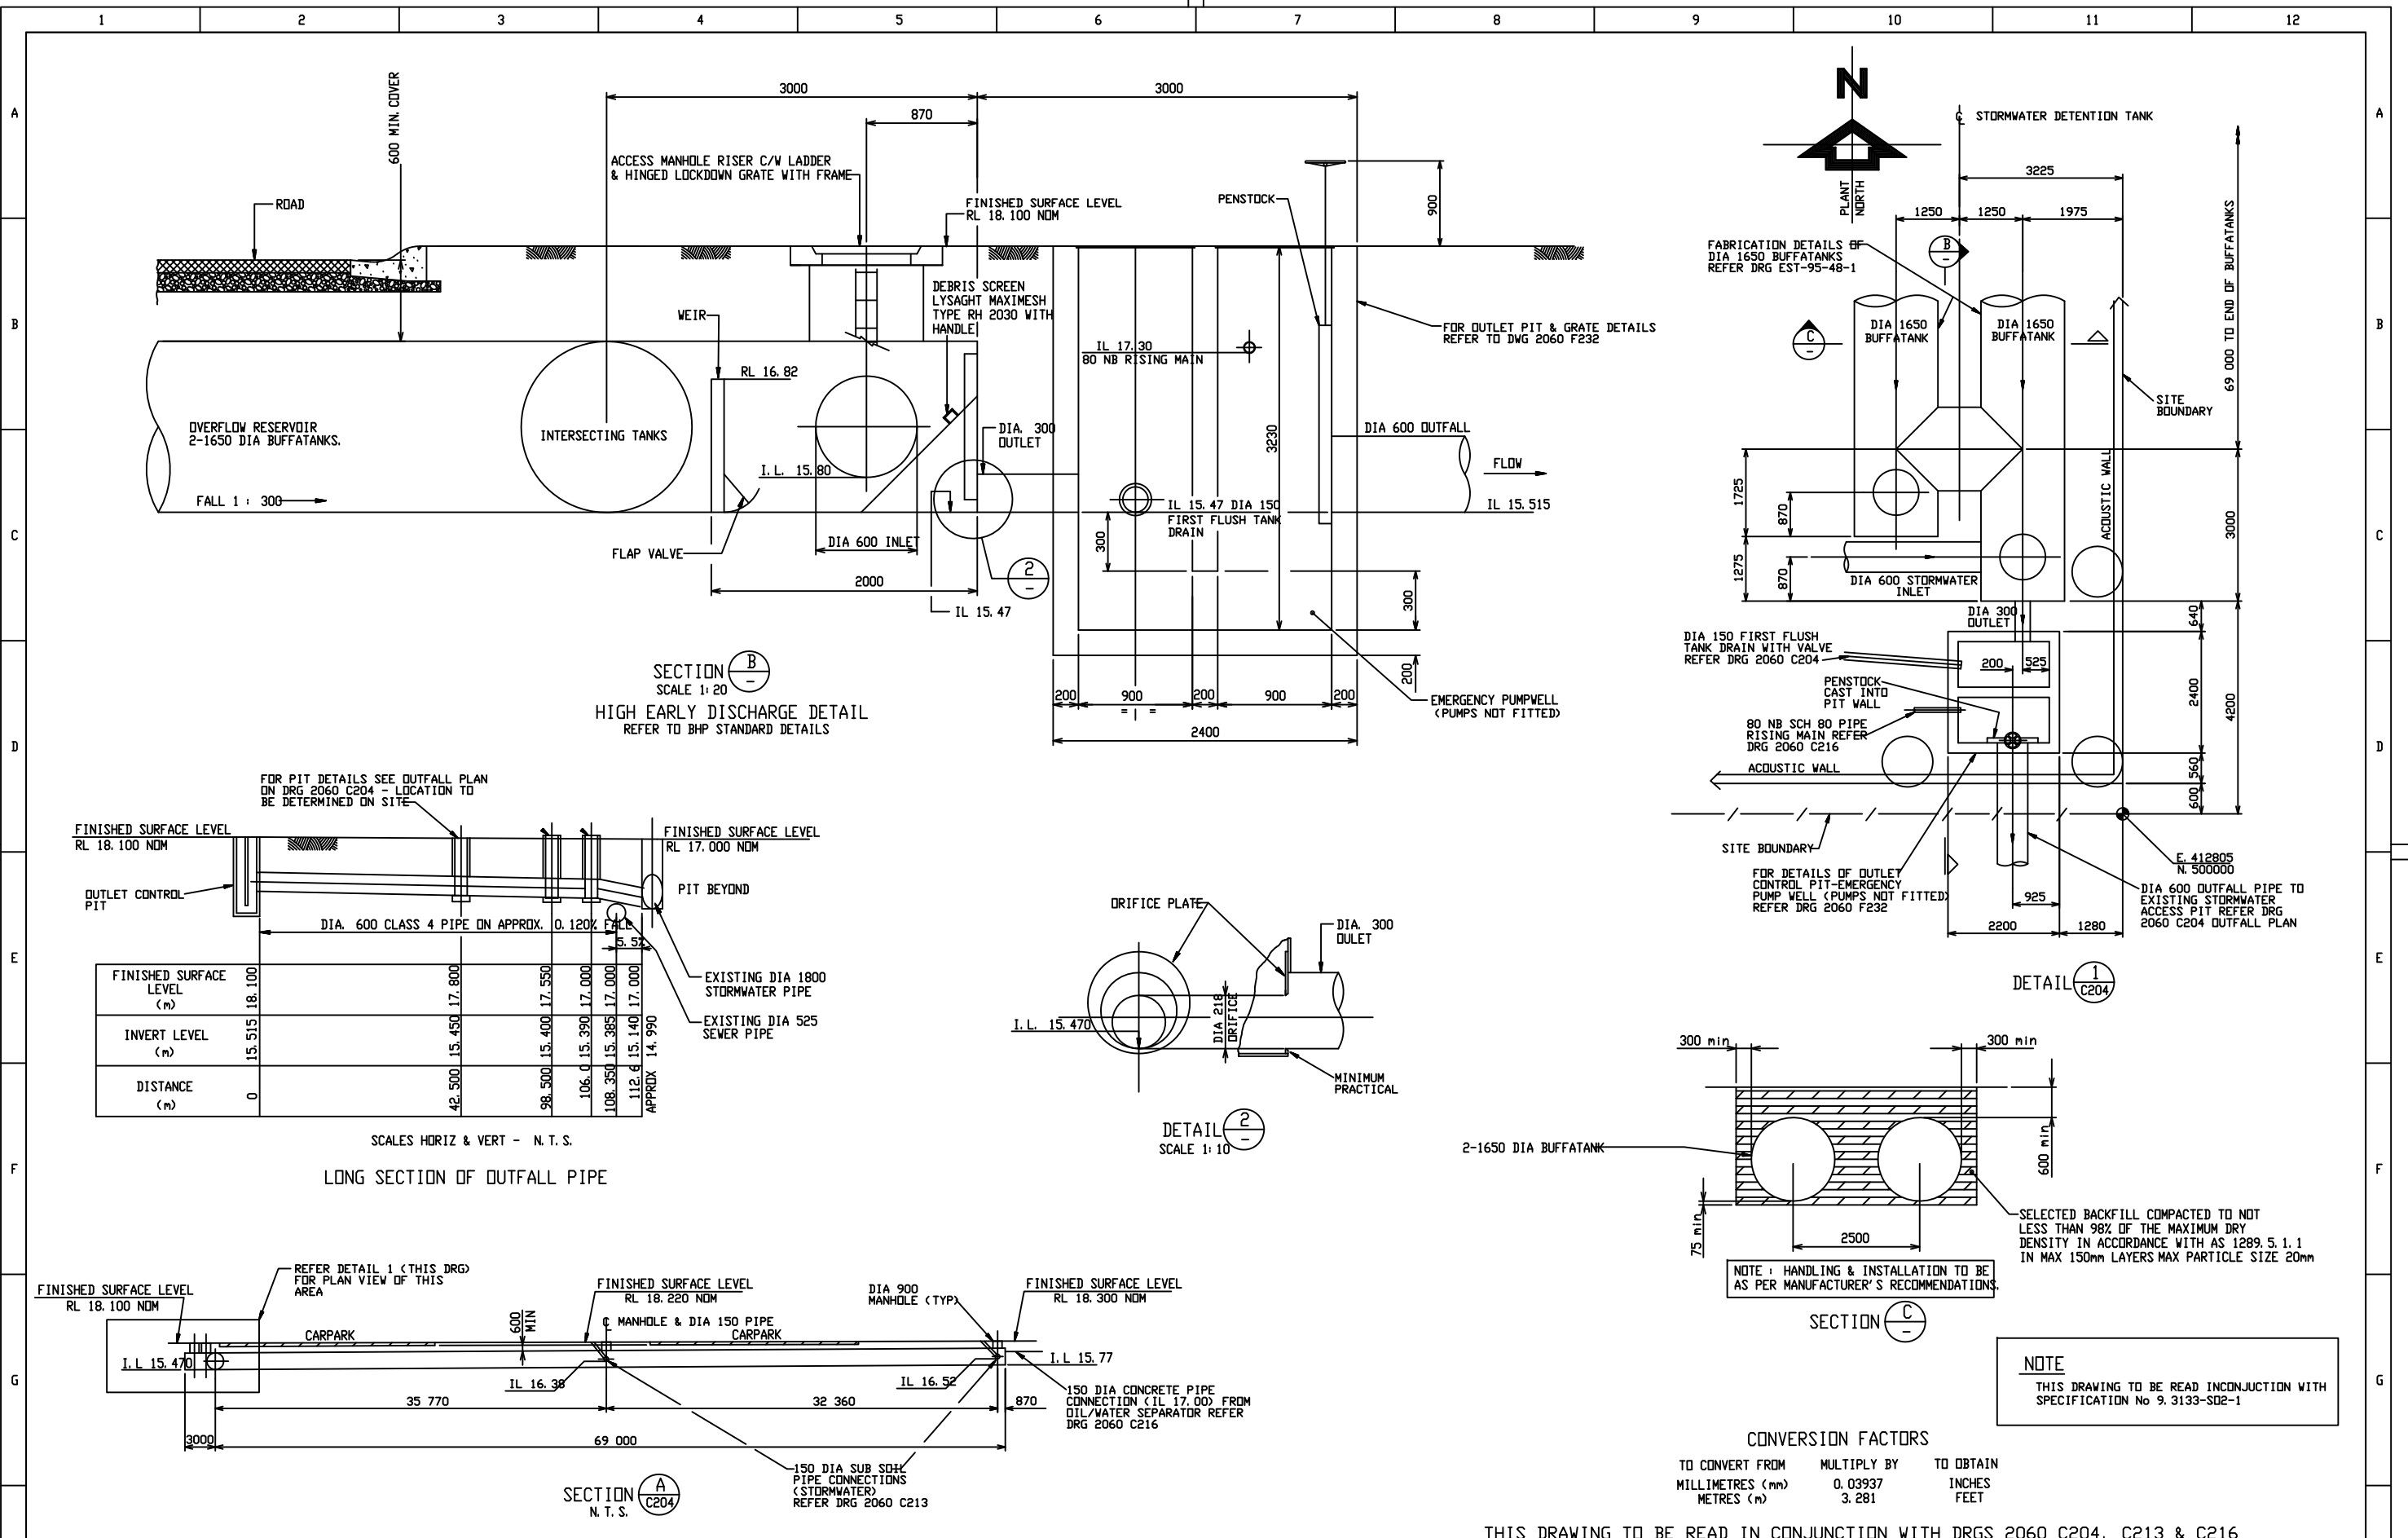


FOR PIT DETAILS SEE OUTFALL PLAN ON DRG 2060 C204 - LOCATION TO BE DETERMINED ON SITE

FINISHED SURFACE LEVEL (m)	INVERT LEVEL (m)	DISTANCE (m)
18.100	15.515	0
17.800	15.450	42.500
17.550	15.400	98.500
17.000	15.390	106.0
17.000	15.385	108.350
17.000	15.140	112.6
17.000	14.990	APPROX 114.990

EXISTING DIA 1800 STORMWATER PIPE  
EXISTING DIA 525 SEWER PIPE

LONG SECTION OF OUTFALL PIPE  
SCALES HORIZ & VERT - N.T.S.

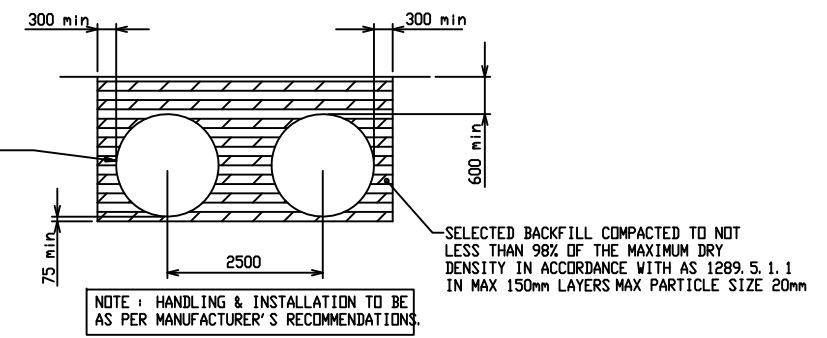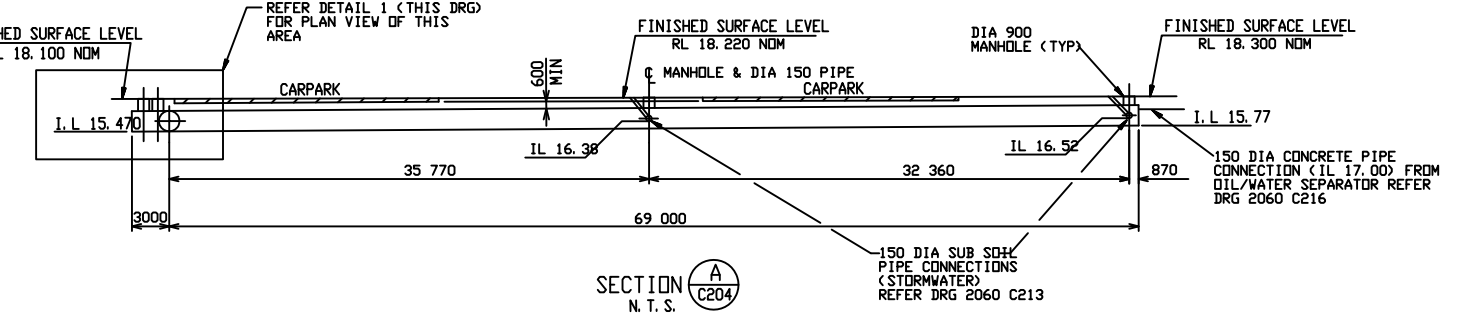

CONVERSION FACTORS

TO CONVERT FROM	MULTIPLY BY	TO OBTAIN
MILLIMETRES (mm)	0.03937	INCHES
METRES (m)	3.281	FEET


THIS DRAWING TO BE READ IN CONJUNCTION WITH DRGS 2060 C204, C213 & C216

REV.	DATE	DRN	CHKD	DESIGNED	VERIFIED	ENG'G'S MANAGER	DESCRIPTION
D	21-1-97	B.F.S.	JFS/PA	-	-	T.S.	AS BUILT
C	30-9-96	B.F.S.	J. DICKSON	J. DICKSON	R. BINNS	T. METEL	REVISED TO SUIT DCN 51. APPROVED FOR CONSTRUCTION
B	1-4-96	B.F.S.	J. DICKSON	J. DICKSON	R. BINNS	R. STEELE	REVISED TO SUIT DCN 45. RE-ISSUED FOR APPROVAL.
A	23-2-96	B. TIERNEY	J. DICKSON	J. DICKSON	R. BINNS	R. STEELE	APPROVED FOR CONSTRUCTION
8	16-2-96	B. TIERNEY	J. DICKSON	J. DICKSON	R. BINNS	R. STEELE	RE-ISSUED FOR APPROVAL
7	20-12-95	B. TIERNEY	J. DICKSON	J. DICKSON	R. BINNS	R. STEELE	GENERAL REVISION & RE-ISSUED FOR APPROVAL

NOTES

- DIMENSIONS IN MILLIMETRES
- DRAWING PRACTICE TO AS 1100


REVISIONS

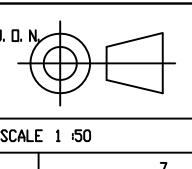

THIS DRAWING AND DESIGN IS THE PROPERTY OF TRANSFIELD CONSTRUCTION PTY. LTD. A.C.N. 000 954 688. IT MUST NOT BE COPIED OR REPRODUCED IN ANY WAY WHATSOEVER AND/OR PASSED ON TO ANY THIRD PARTY WITHOUT WRITTEN AUTHORITY FROM TRANSFIELD CONSTRUCTION PTY. LTD. 100 ARTHUR STREET, NORTH SYDNEY 2060, N.S.W. AUSTRALIA. TEL. (02) 929 8600, FAX. (02) 954 0538


SMITHFIELD ENERGY FACILITY  
SMITHFIELD, N.S.W. AUSTRALIA  
SITE DRAINAGE STORMWATER  
DETENTION TANK  
DETAILS & SECTIONS

DRG NO.	2060 C206
SHEET 1/1	
B1	0123456 78ABC D

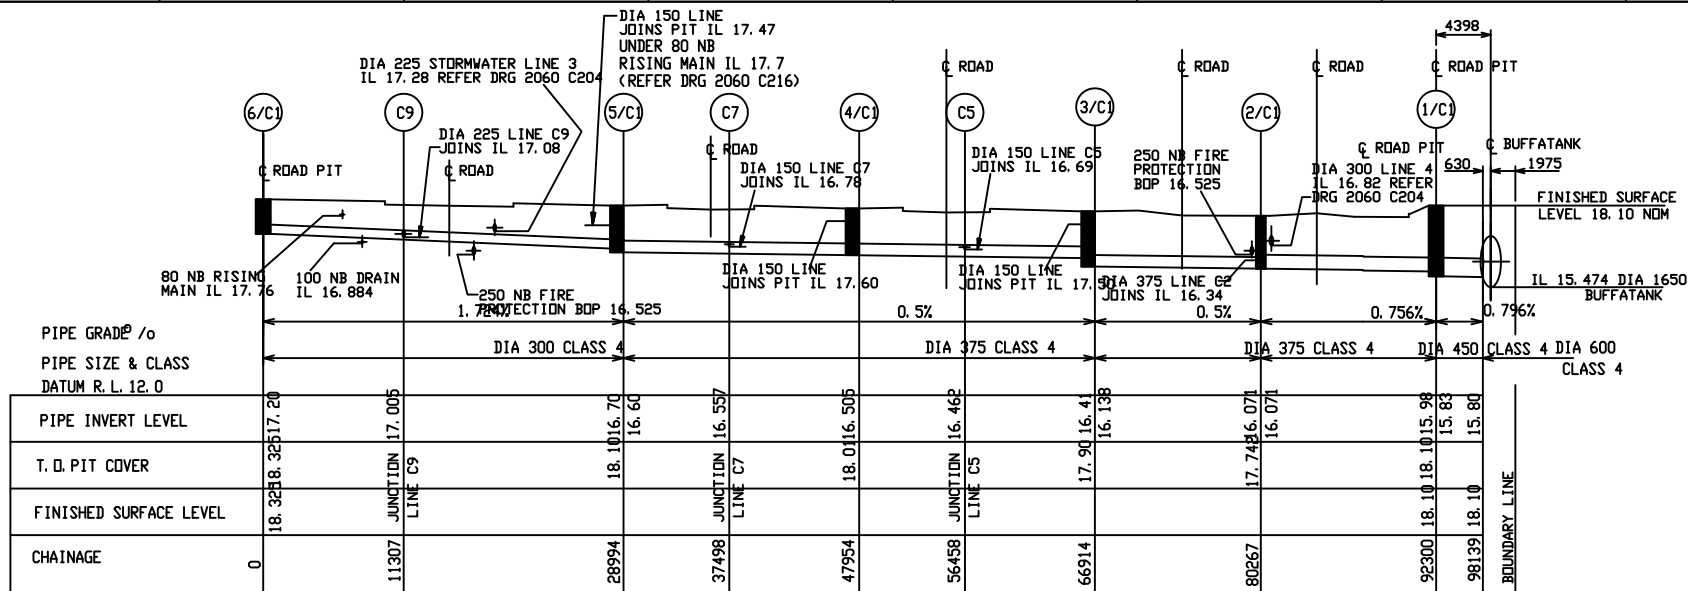


STORMWATER DRAINAGE LONGITUDINAL SECTION - LINE C1

SCALE HORIZONTAL 1 : 250  
VERTICAL 1 : 100

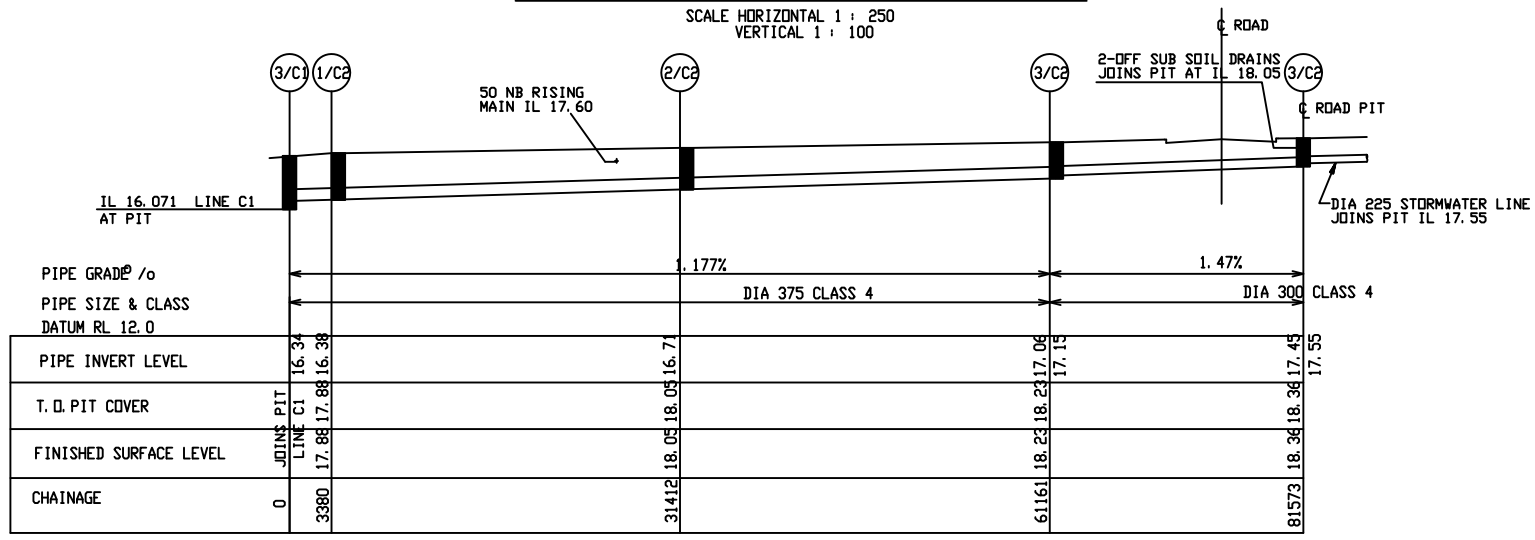


STORMWATER DRAINAGE LONGITUDINAL SECTION - LINE C2

SCALE HORIZONTAL 1 : 250  
VERTICAL 1 : 100

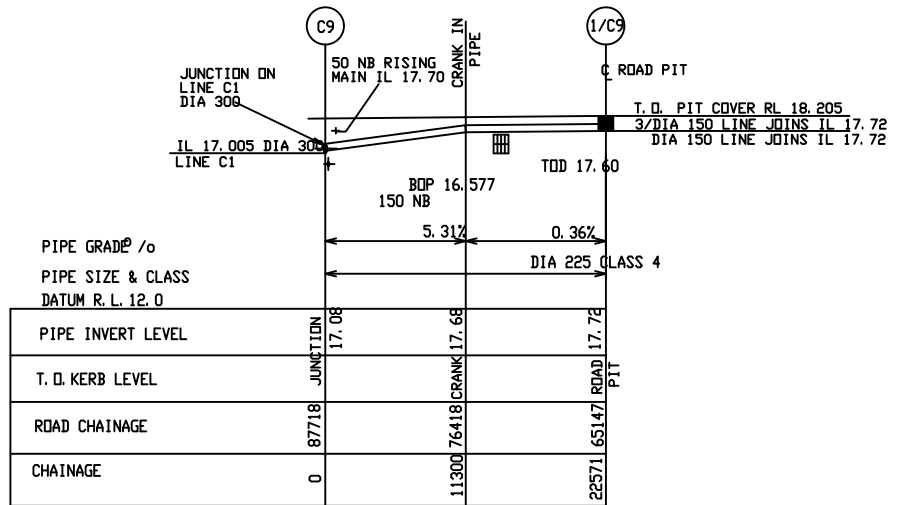


STORMWATER DRAINAGE LONGITUDINAL SECTION - LINE 3A

SCALE HORIZONTAL 1 : 250  
VERTICAL 1 : 100

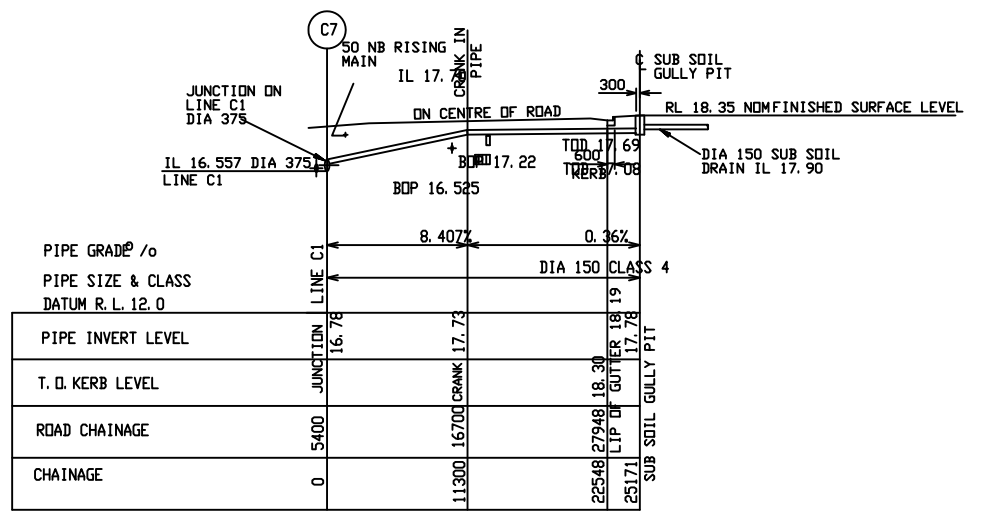

STORMWATER DRAINAGE LONGITUDINAL SECTION - LINE C7

SCALE HORIZONTAL 1 : 250  
VERTICAL 1 : 100

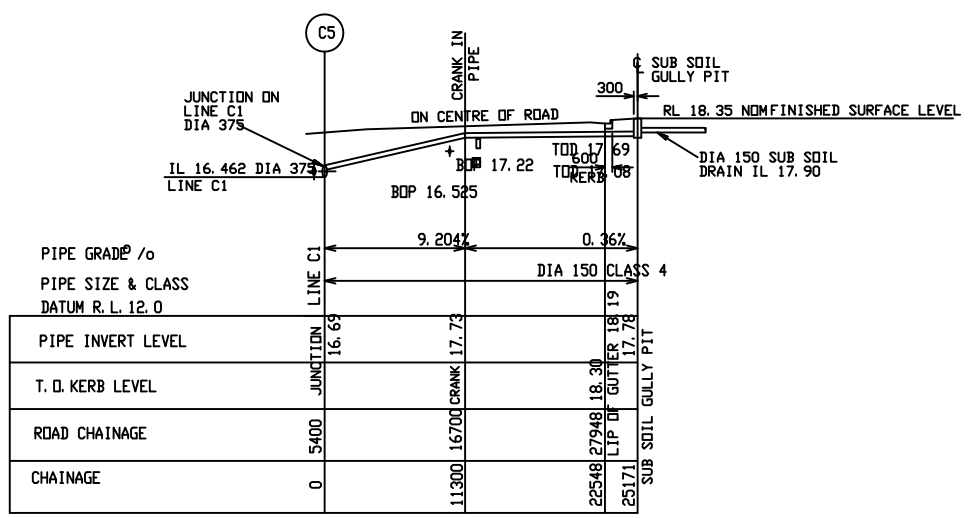

STORMWATER DRAINAGE LONGITUDINAL SECTION - LINE C5

SCALE HORIZONTAL 1 : 250  
VERTICAL 1 : 100

GENERAL NOTES

THIS DRAWING TO BE READ IN CONJUNCTION WITH SPECIFICATION No. 9.3133-S02-1

NOMENCLATURE : TOD : TOP OF DUCT  
TOP : TOP OF PIPE  
BOP : BOTTOM OF PIPE



CONVERSION FACTORS

TO CONVERT FROM MILLIMETRES (mm) TO METRES (m) MULTIPLY BY 0.001  
TO OBTAIN INCHES FEET MULTIPLY BY 0.0254

THIS DRAWING TO BE READ IN CONJUNCTION WITH DRG 2060 C213

REV.	DATE	DRN	CHKD	DESIGNED	VERIFIED	ENG. DES. MANAGER	DESCRIPTION
D	21-1-97	B.F.S.	BFS/HA	-	-	T.S.	AS BUILT
B	1-4-96	B.F.S.	J. DICKSON	J. DICKSON	R. BINNS	R. STEELE	REVISED AS PER DCN49, RE-ISSUED FOR APPROVAL.
A	23-2-96	D. TIERNEY	J. DICKSON	J. DICKSON	R. BINNS	R. STEELE	APPROVED FOR CONSTRUCTION
I	16-2-94	D. TIERNEY	J. DICKSON	J. DICKSON	R. BINNS	R. STEELE	RE-ISSUED FOR APPROVAL
0							ISSUED FOR APPROVAL.

NOTES
1. DIMENSIONS IN MILLIMETRES
2. DRAWING PRACTICE TO AS 1100

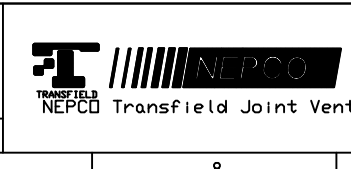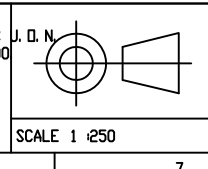

THIS DRAWING AND DESIGN IS THE PROPERTY OF TRANSFIELD CONSTRUCTION PTY. LTD. A.C.N. 000 954 688. IT MUST NOT BE COPIED OR REPRODUCED IN ANY WAY WHATSOEVER AND/OR PASSED ON TO ANY THIRD PARTY WITHOUT WRITTEN AUTHORITY FROM TRANSFIELD CONSTRUCTION PTY. LTD. 100 ARTHUR STREET, NORTH SYDNEY 2060, N.S.W. AUSTRALIA. TEL. (02) 929 8600, FAX. (02) 954 0538

SMITHFIELD ENERGY FACILITY  
SMITHFIELD, N.S.W. AUSTRALIA  
SITE DRAINAGE  
STORMWATER & SEWER RETICULATION  
LONGITUDINAL SECTIONS

DRG NO.	2060 C219
SHEET 1/1	
B1	01A B C D

## APPENDIX E – Flood impact assessment

The following outlines the flood impact assessment undertaken for the Project. Cumberland City Council (Council) has advised that the Project Site is classified as a flood control lot and therefore impacted by the 1% AEP (100 year ARI) flood event. In accordance with Council's flood advice letter dated the 2<sup>nd</sup> of August 2023:

*In all cases, flood level on adjacent properties shall not be increased.  
Supporting documentation is to accompany the development.*

The following summarises the flood modelling undertaken to assess the potential impact of the Project on flood conditions for the surrounding properties. An assessment of the potential impacts of the Project has also been undertaken based on an indicative footprint of the proposed works.

### E.1 Hydraulic modelling overview

This flood assessment has been undertaken using the flood model provided by Council in September 2023 taken from the Holroyd City LGA Overland Flood Study prepared by Lyall & Associated Consulting Water Engineers in June 2017. Arcadis has refined the flood model to better represent the existing conditions of the Project Site. Further refinement has also been undertaken to represent the indicative footprint of the Project. The methodology of the Council flood modelling and mapping has been maintained as summarised below.

#### E.1.1 Cumberland Council flood model

The Council flood model is a two-dimensional (2D) TUFLOW model with hydrological and hydraulic approaches based on Australian Rainfall and Runoff 1987 methodology. The TUFLOW model was developed based on September 2011 aerial photography and April 2013 airborne laser scanning survey. DRAINS hydrological modelling was undertaken to provide inflow hydrographs to the TUFLOW 2D domain. The TUFLOW model utilises a 2m grid resolution and incorporates Council's drainage network into the model as one-dimensional elements. Within the 2D domain building footprints are described as areas of high hydraulic roughness to represent the effect of buildings on the passage of overland flow.

The TUFLOW hydraulic simulations were undertaken using the TUFLOW Classic double precision 2013-12-AC-w64 build for design rainfall events ranging between the 20% AEP (5 year ARI) and 1% AEP (100 year ARI) as well as the Probable Maximum Flood (PMF).

The TUFLOW model was developed to define the nature of overland flow and not mainstream flooding such as that from Prospect Creek located south of the Project Site. For the Project Site the TUFLOW model can be used for the simulation of design rainfall events up to and including the 1% AEP event. For the PMF design event the entirety of the Project Site is inundated from Prospect Creek mainstream flooding which Council relies on alternative previous studies to define.

#### E.1.2 Existing conditions model refinement

The following refinement has been undertaken to Council's TUFLOW model to represent the existing conditions of the Project Site more accurately (as illustrated in Figure E-1):

- 1) The extent of the TUFLOW model has been reduced to the local catchment to enable faster simulation times, reducing the 2D domain from 17,000 to 476 hectares
- 2) Building footprint extents in the immediate area and within the Project Site have been revised based on 2023 aerial photography, 2023 site photographs (Appendix B) and historical site drawings (see Appendix D)

- 3) The existing water tank at the Project Site entrance has been raised above the peak flood level to avoid flood water entering this confined water-tight space
- 4) The internal roadways have been defined as areas with a hydraulic roughness of 0.02, in line with the public roadways elsewhere in the model
- 5) The solid external perimeter walls of the Project Site have been incorporated as outlined below.

Within the TUFLOW model, z-shapes have been used for the representation of the external perimeter walls of the Project site as follows:

- The western boundary walls are assumed to be continuous on either side of the Project Site entrance and elevated above the peak flood level.
- The acoustic wall along the southern boundary has been elevated above the peak water level. It has been assumed that the vehicle roller shutter door is raised during a large flood event allowing for the passage of overland flow.
- The portion of the acoustic wall along the eastern boundary has been elevated above the peak water level. The short wall of blockwork along the remainder of the eastern boundary has been raised to an estimated height of 100mm to 200mm above the surrounding ground surface.
- The northern Colourbond fence has not been incorporated into the model as some flows may pass beneath the structure, and the fence may not remain stable and upright during a large flood event.

Whilst an internal drainage network is present within the Project Site, this has not been incorporated into the TUFLOW model at this stage. The capacity of this minor drainage network is expected to be less than the 1% AEP flood event being assessed. Omitting this drainage network from the model will produce more conservative flood levels within the Project Site.

No change has been made to the hydrological model inputs to the TUFLOW model and simulations have been undertaken maintaining the TUFLOW Classic double precision 2013-12-AC-w64 build.

### **E.1.3 Project conditions model refinement**

A representation of the Project has been developed within the TUFLOW model based on an indicative footprint of the proposed works. For the purpose of the flood assessment, it has been assumed that any structures or infrastructure at ground level will be raised above the 1% AEP flood level with a minimum horizontal clearance of 1 metre from the existing internal roadway gutter. No other changes have been made to the ground surface levels within the TUFLOW model. The extent of the Project considered in the TUFLOW model is illustrated in Figure E-2.

### **E.1.3 Hydraulic results**

For both the existing and Project conditions the critical duration of the 1% AEP flood event across the Project Site is relatively short, ranging from 25 minutes to 120 minutes, resulting in flash flooding conditions with little warning time.

Flood mapping has been prepared for the 1% AEP design event as per the Prospect Creek Overland Flood Study (2017) such that:

- Peak flood results have been taken as the maximum envelope of the 25, 60, 90, 120, 180 and 270 minute design storm events
- Flood depths less than 100 mm have not been shown
- Flooding within building footprints has been omitted.

A range of flood mapping has been prepared as follows:

- Existing Conditions
  - Figure E-3 1% AEP Flood Depth
  - Figure E-4 1% AEP Maximum Water Level
- Project Conditions
  - Figure E-5 1% AEP Flood Depth
  - Figure E-6 1% AEP Maximum Water Level
- Flood Impact Mapping
  - Figure E-7 1% AEP Maximum Water Level Difference

## E.2 Findings

The flood modelling demonstrates the overland flow paths entering the Project Site across the western and eastern boundaries. For the Project Site in the 1% AEP flood event:

- Peak flood depths occur at low points along the internal roadways with up to 0.4m at the Project Site entrance, and up to 0.5m in the southeast corner of the Project Site
- Peak velocities across the Project Site are generally less than 1m/s
- With a depth velocity product less than 0.3m<sup>2</sup>/s, the hazard classification reaches H2 (unsafe for small vehicles) at the deeper road low points with the remainder of the Project Site considered generally safe for vehicles, people and buildings based on the Australian Institute for Disaster Resilience general flood hazard vulnerability curve.

The flood impact mapping provided in Figure E-7 demonstrates that the modelled Project extent does not have a significant adverse impacts on overland flow flood levels for the surrounding properties. The Project extent does not significantly impede the overland flow entering the Project Site from the western and eastern Project Site boundaries and does not divert or redirect overland flow paths within the Project Site. Peak flood level increases greater than 0.01m are limited to the area within the Project Site.

The flood assessment undertaken has been based on an indicative footprint of the proposed works based on information currently available. The extent and levels of the proposed infrastructure and buildings of the Project are subject to refinement at detailed design at which time further flood modelling is recommended to confirm the findings of this assessment.



Figure:  
**E-1**

Title: **Smithfield BESS  
TUFLOW Model Features - Existing Conditions**

Rev:  
**A**



0 12.5 25m  
Approx. Scale





Figure:  
**E-2**

Title: **Smithfield BESS  
TUFLOW Model Features - Project Conditions**

Rev:  
**A**



0 12.5 25m  
Approx. Scale


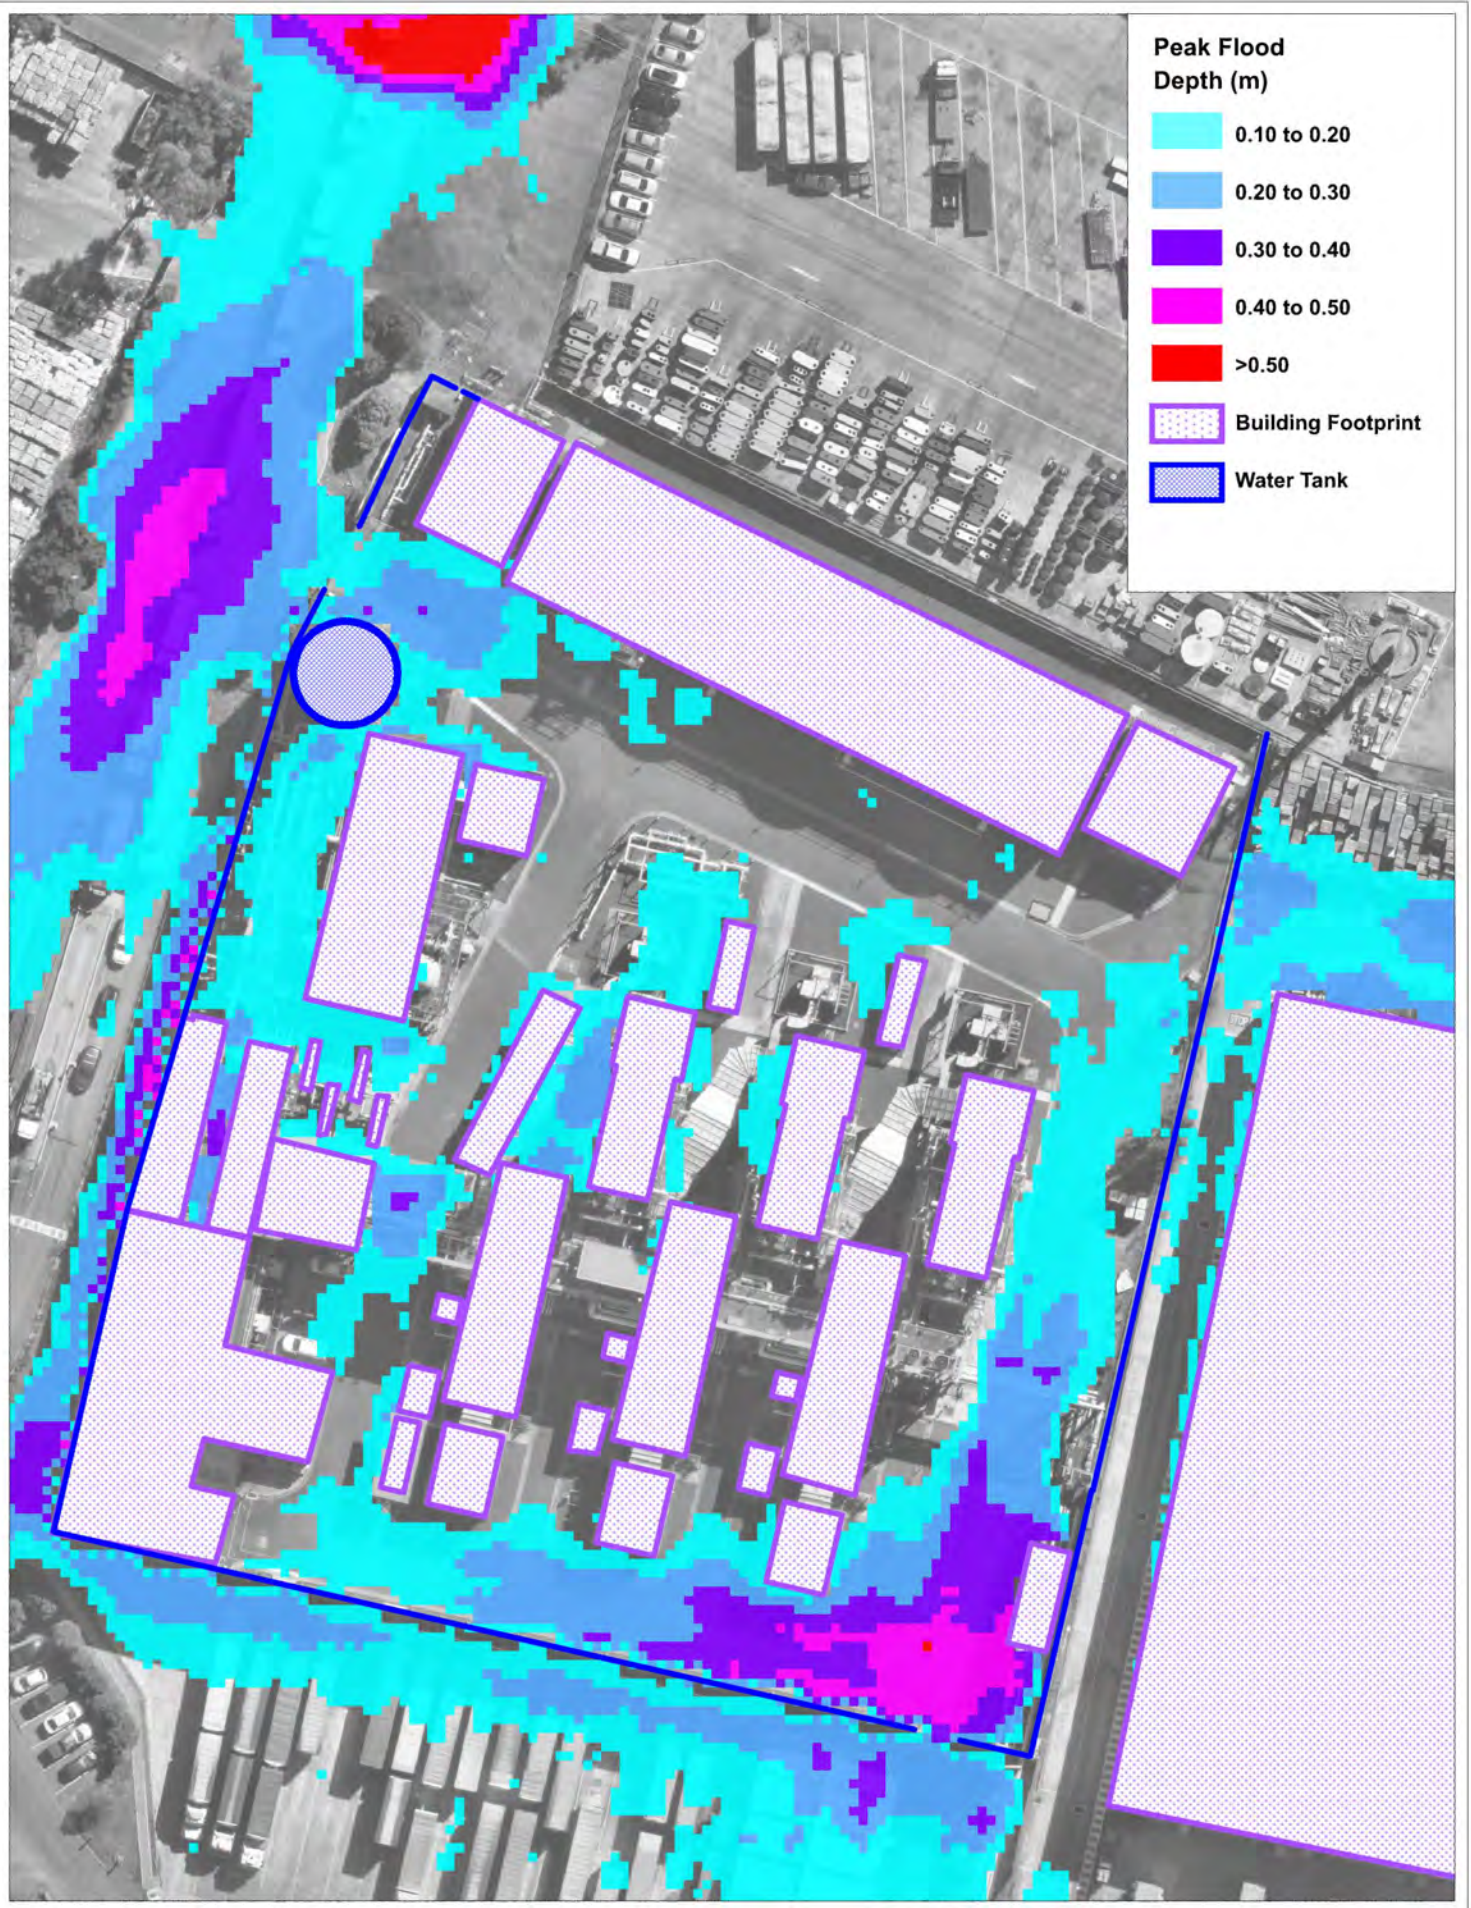


Figure:  
**E-3**

Title: **Smithfield BESS  
1% AEP Flood Depth - Existing Conditions**

Rev:  
**A**

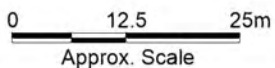

Note: Overland flood modelling only.  
Flood depths less than 100 mm have not been shown.

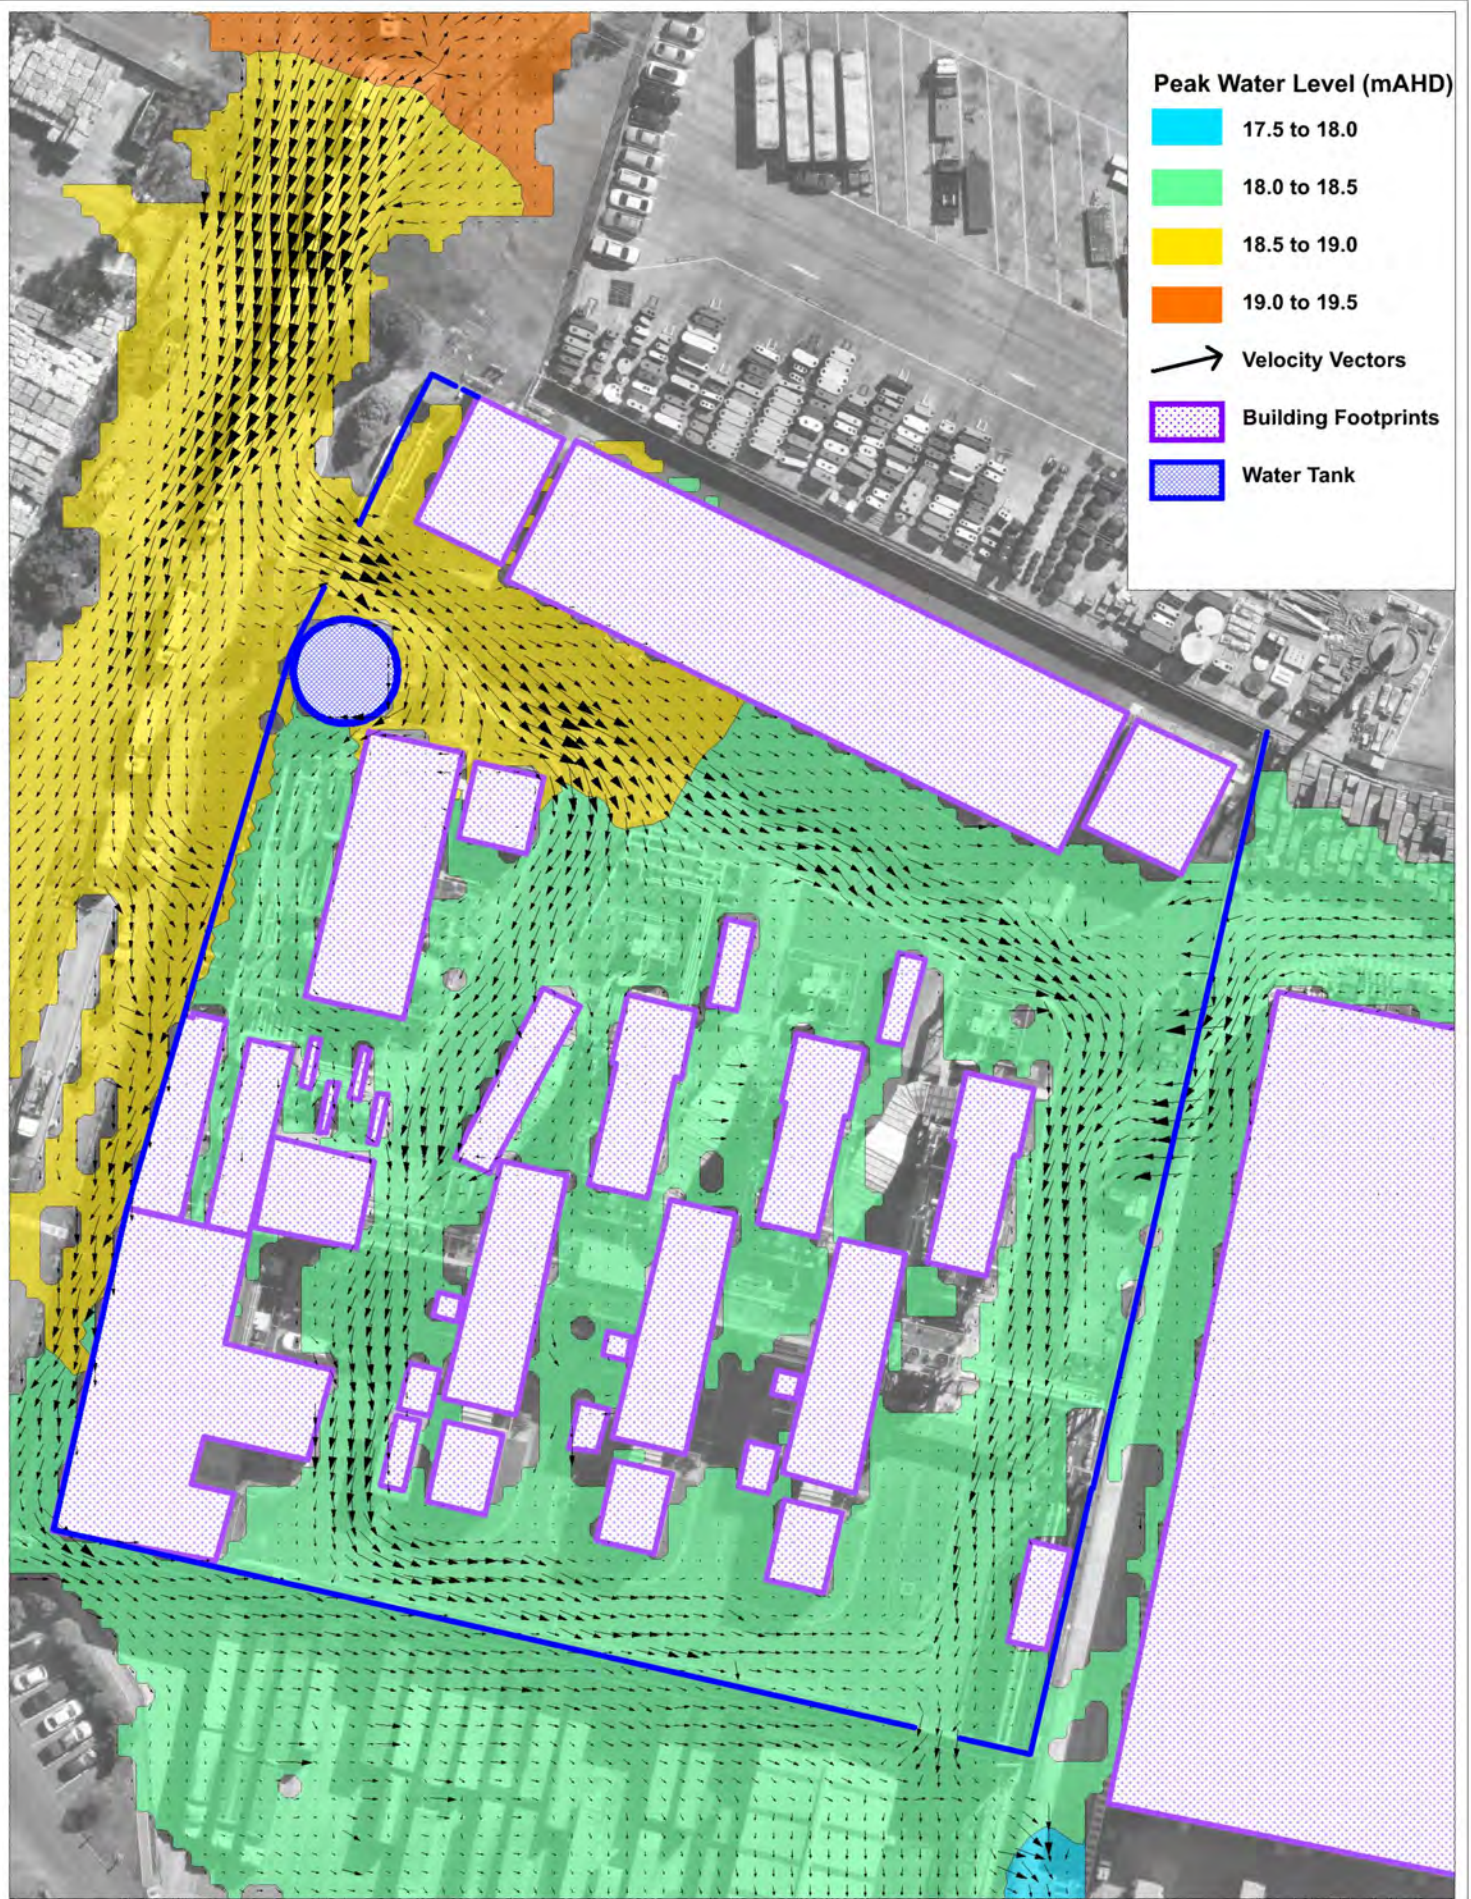


Figure:  
**E-4**

Title: **Smithfield BESS  
1% AEP Flood Maximum Water Level- Existing Conditions**

Rev:  
**A**



0 12.5 25m  
Approx. Scale

Note: Overland flood modelling only.

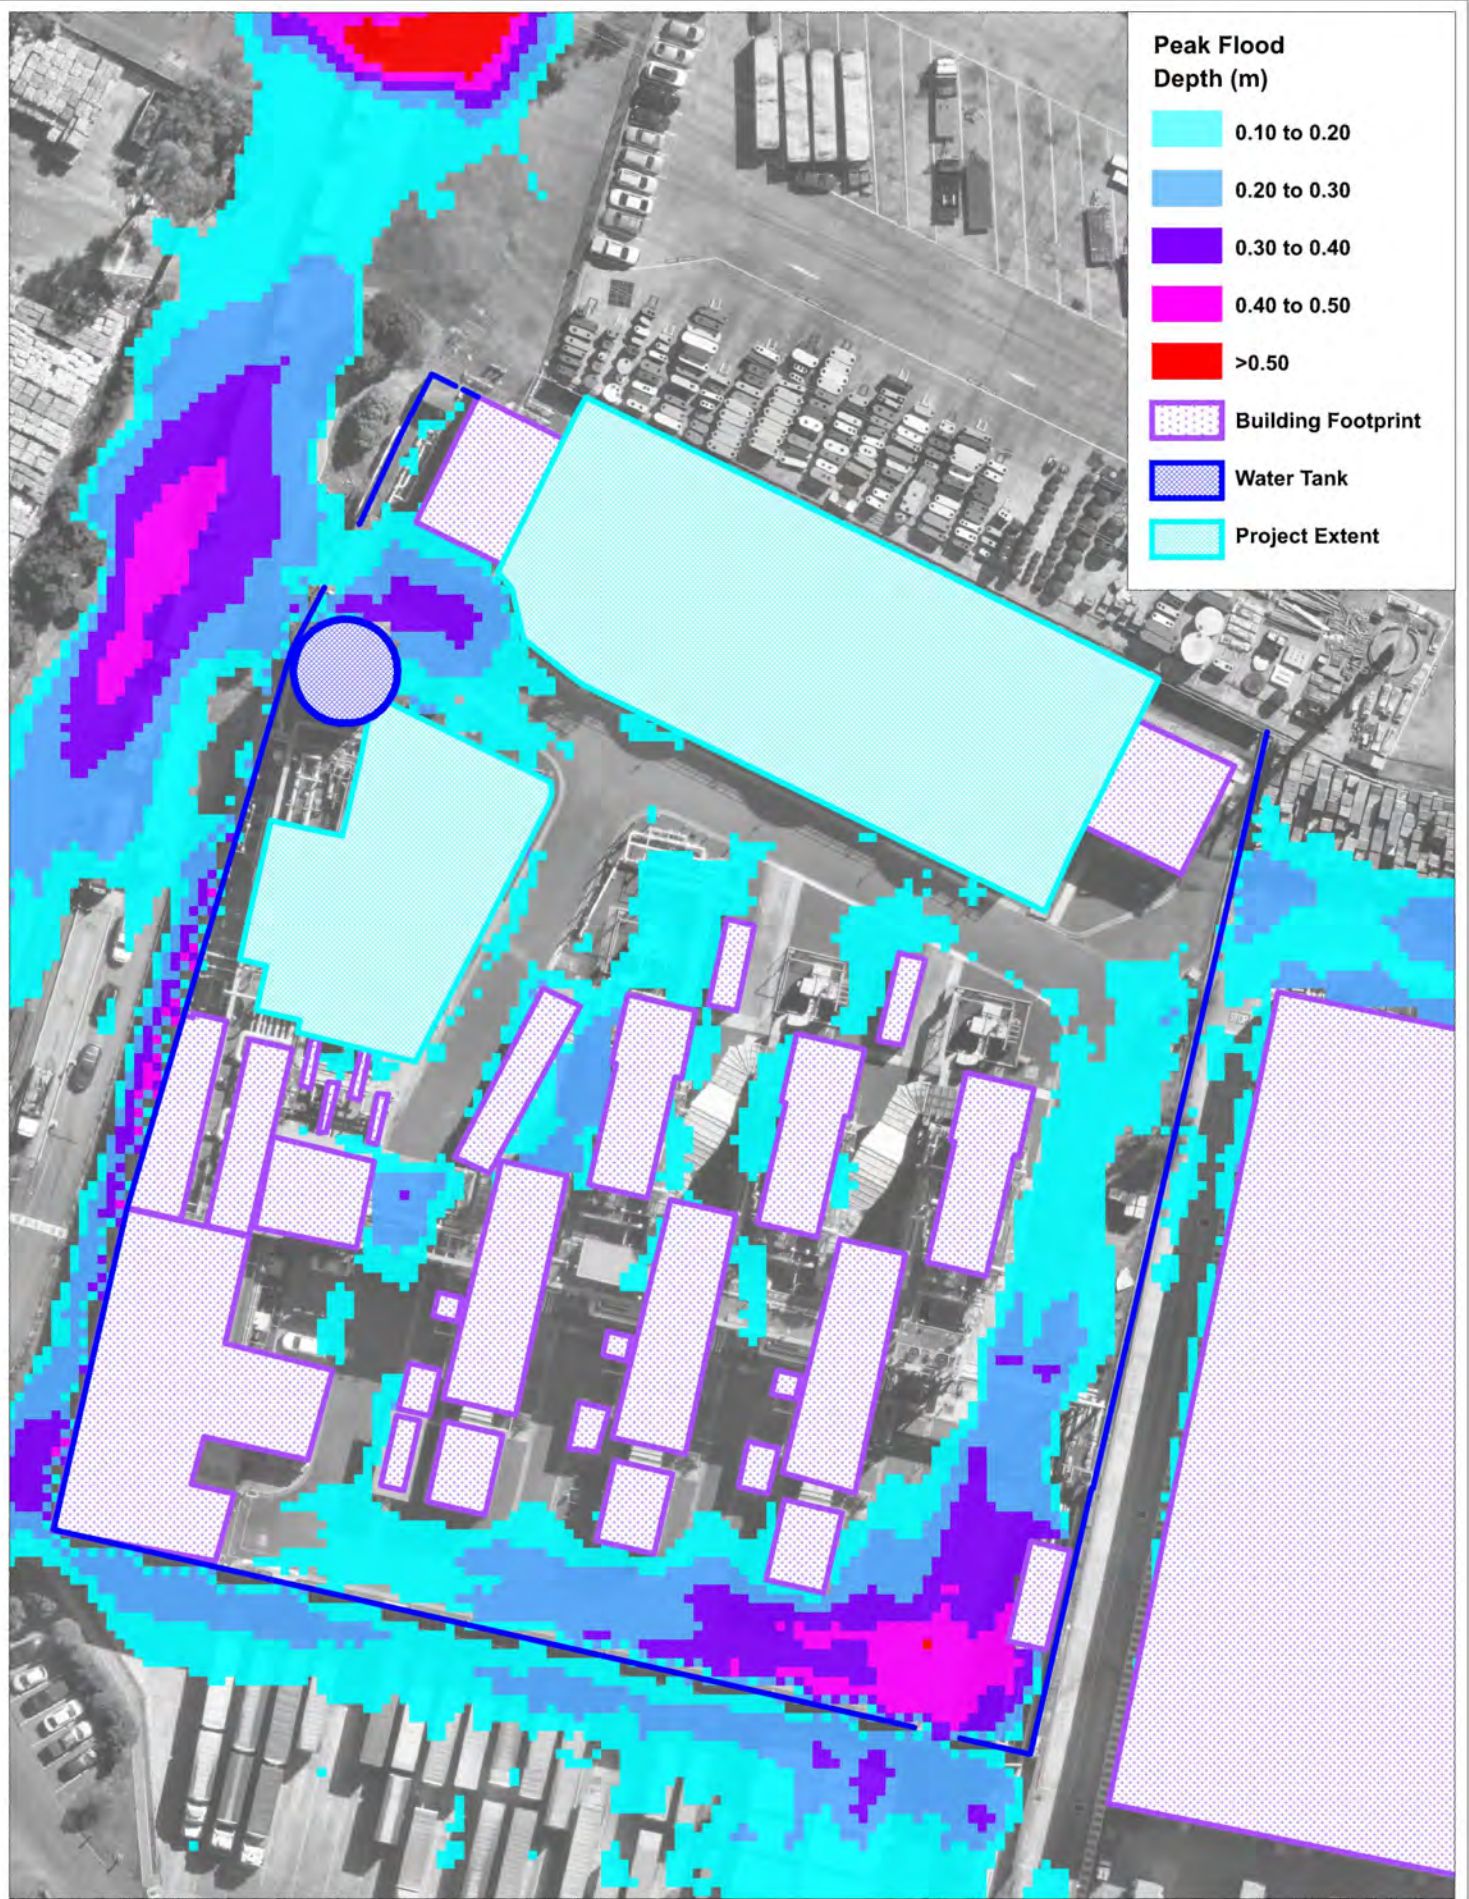


Figure:  
**E-5**

Title: **Smithfield BESS  
1% AEP Flood Depth - Project Conditions**

Rev:  
**A**



0 12.5 25m  
Approx. Scale

Note: Overland flood modelling only.  
Flood depths less than 100 mm have not been shown.

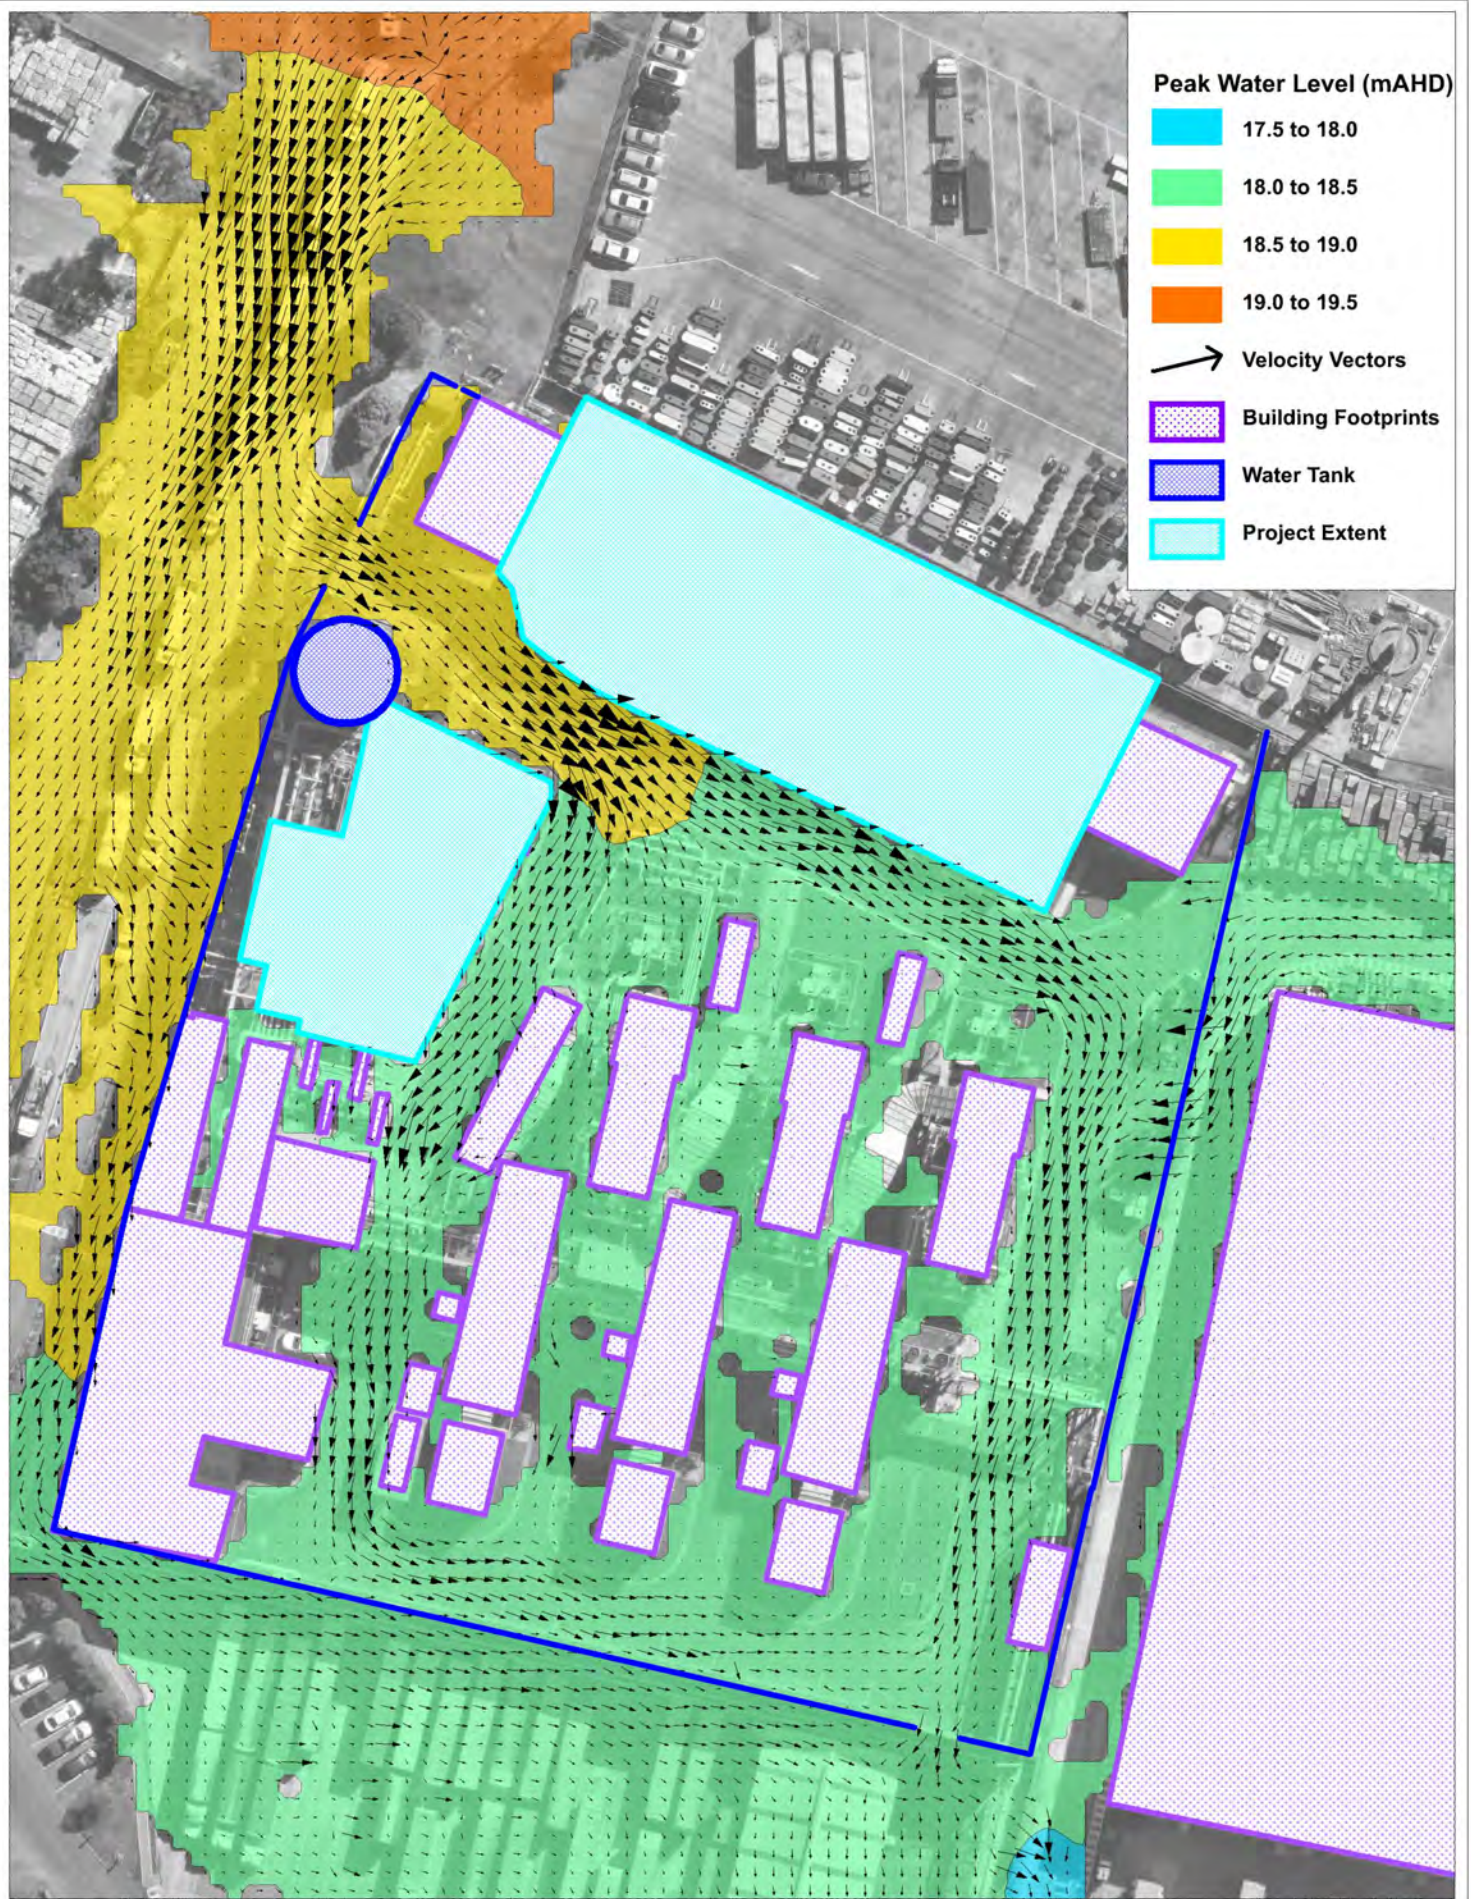


Figure: **E-6**

Title: **Smithfield BESS  
1% AEP Flood Maximum Water Level- Project Conditions**

Rev: **A**



0 12.5 25m  
Approx. Scale

Note: Overland flood modelling only.

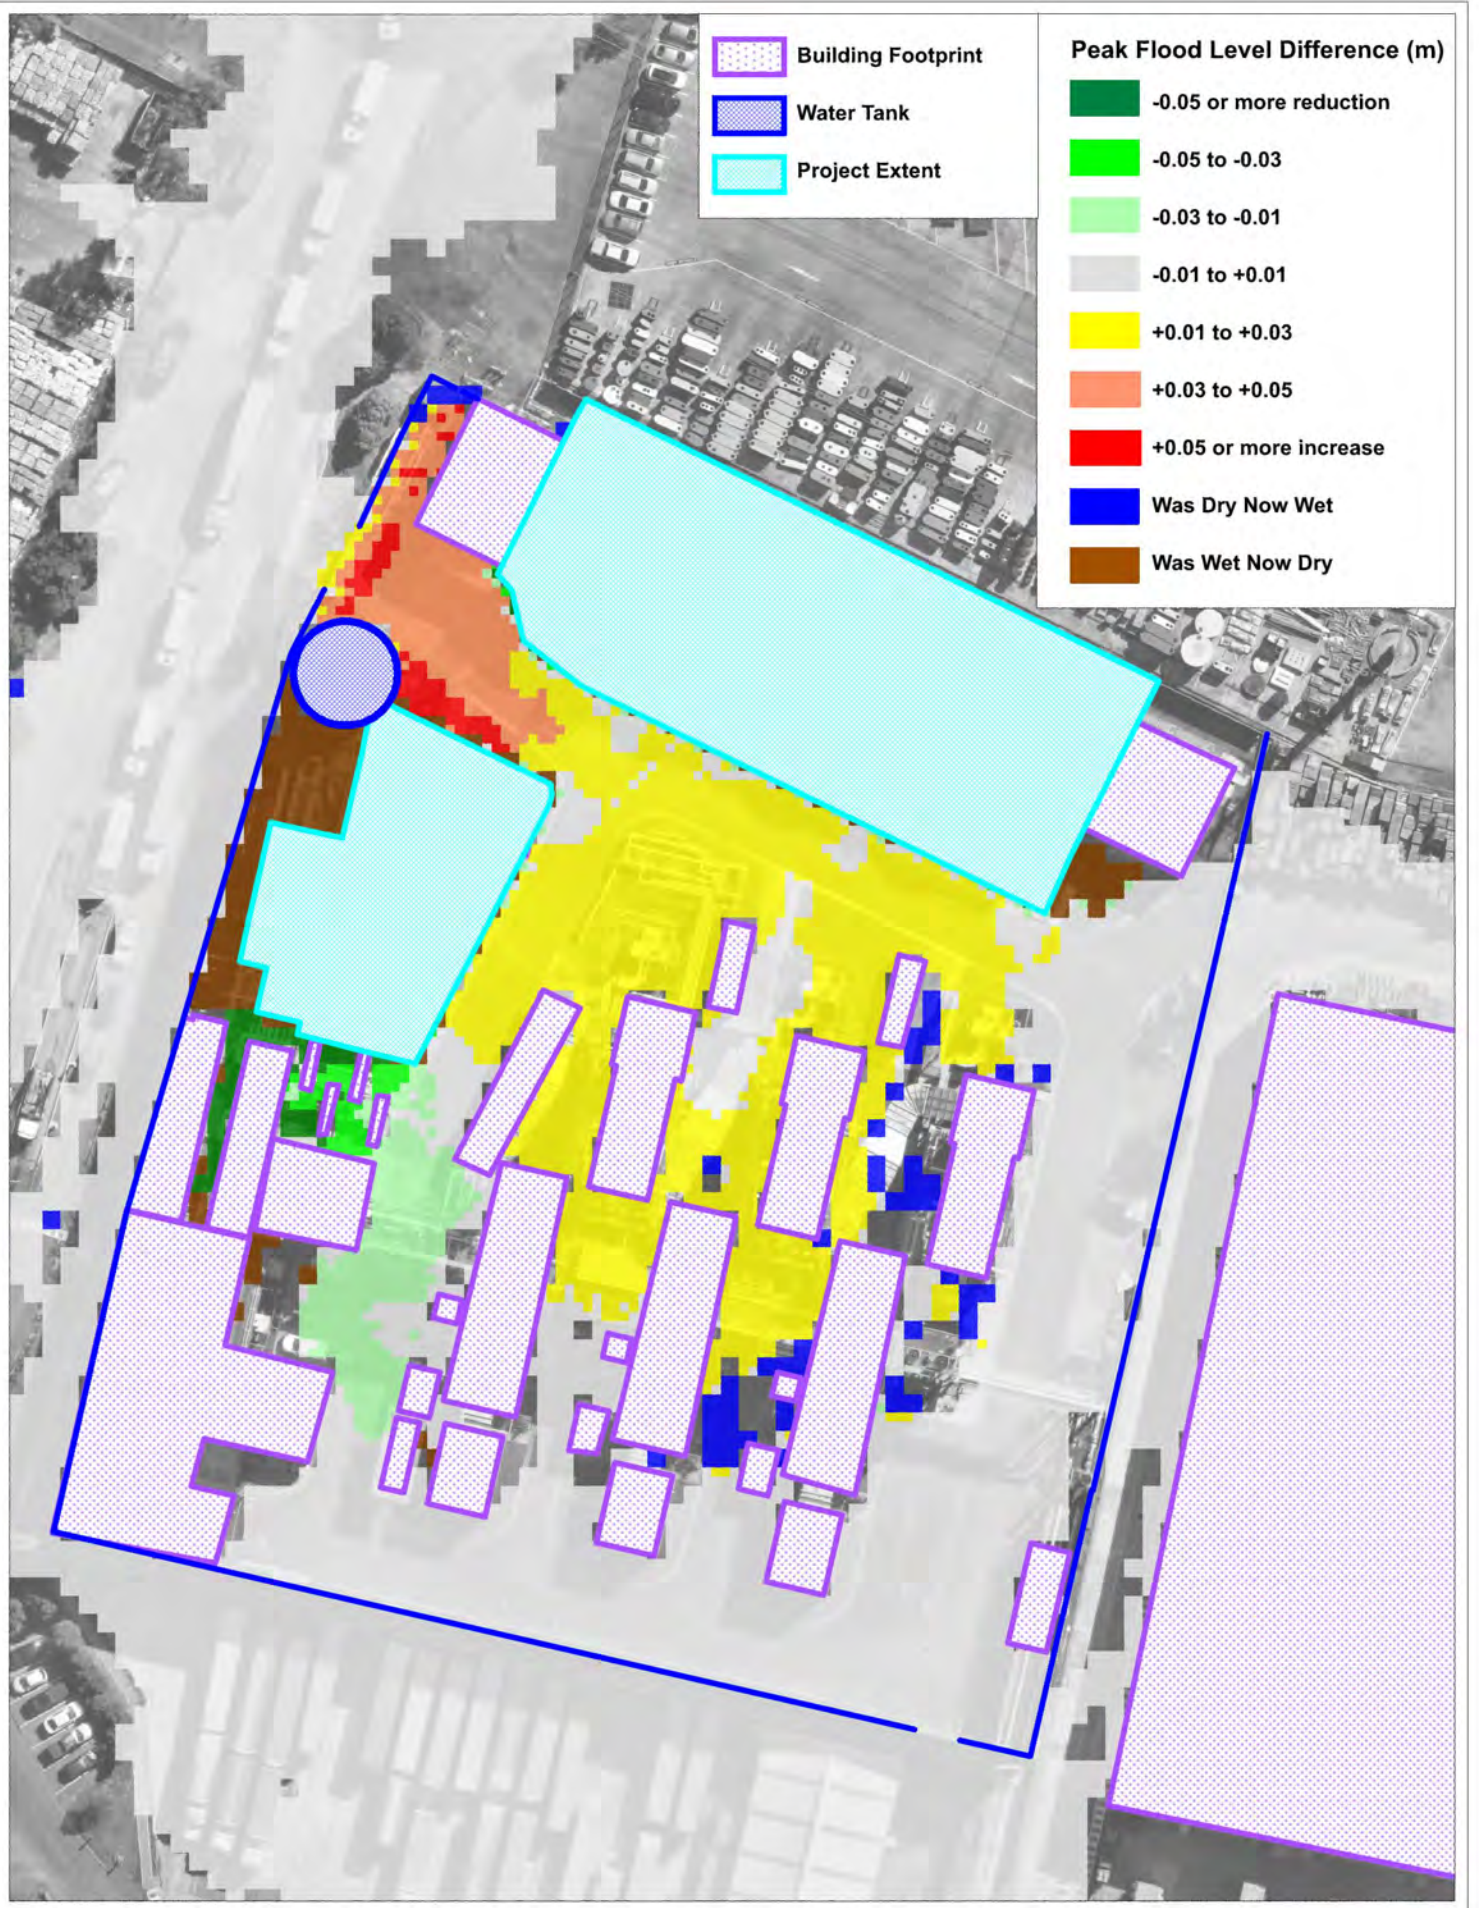


Figure:  
**E-7**

Title: **Smithfield BESS  
1% AEP Maximum Water Level Differences**

Rev:  
**A**



0 12.5 25m  
Approx. Scale

Note: Overland flood modelling only.